
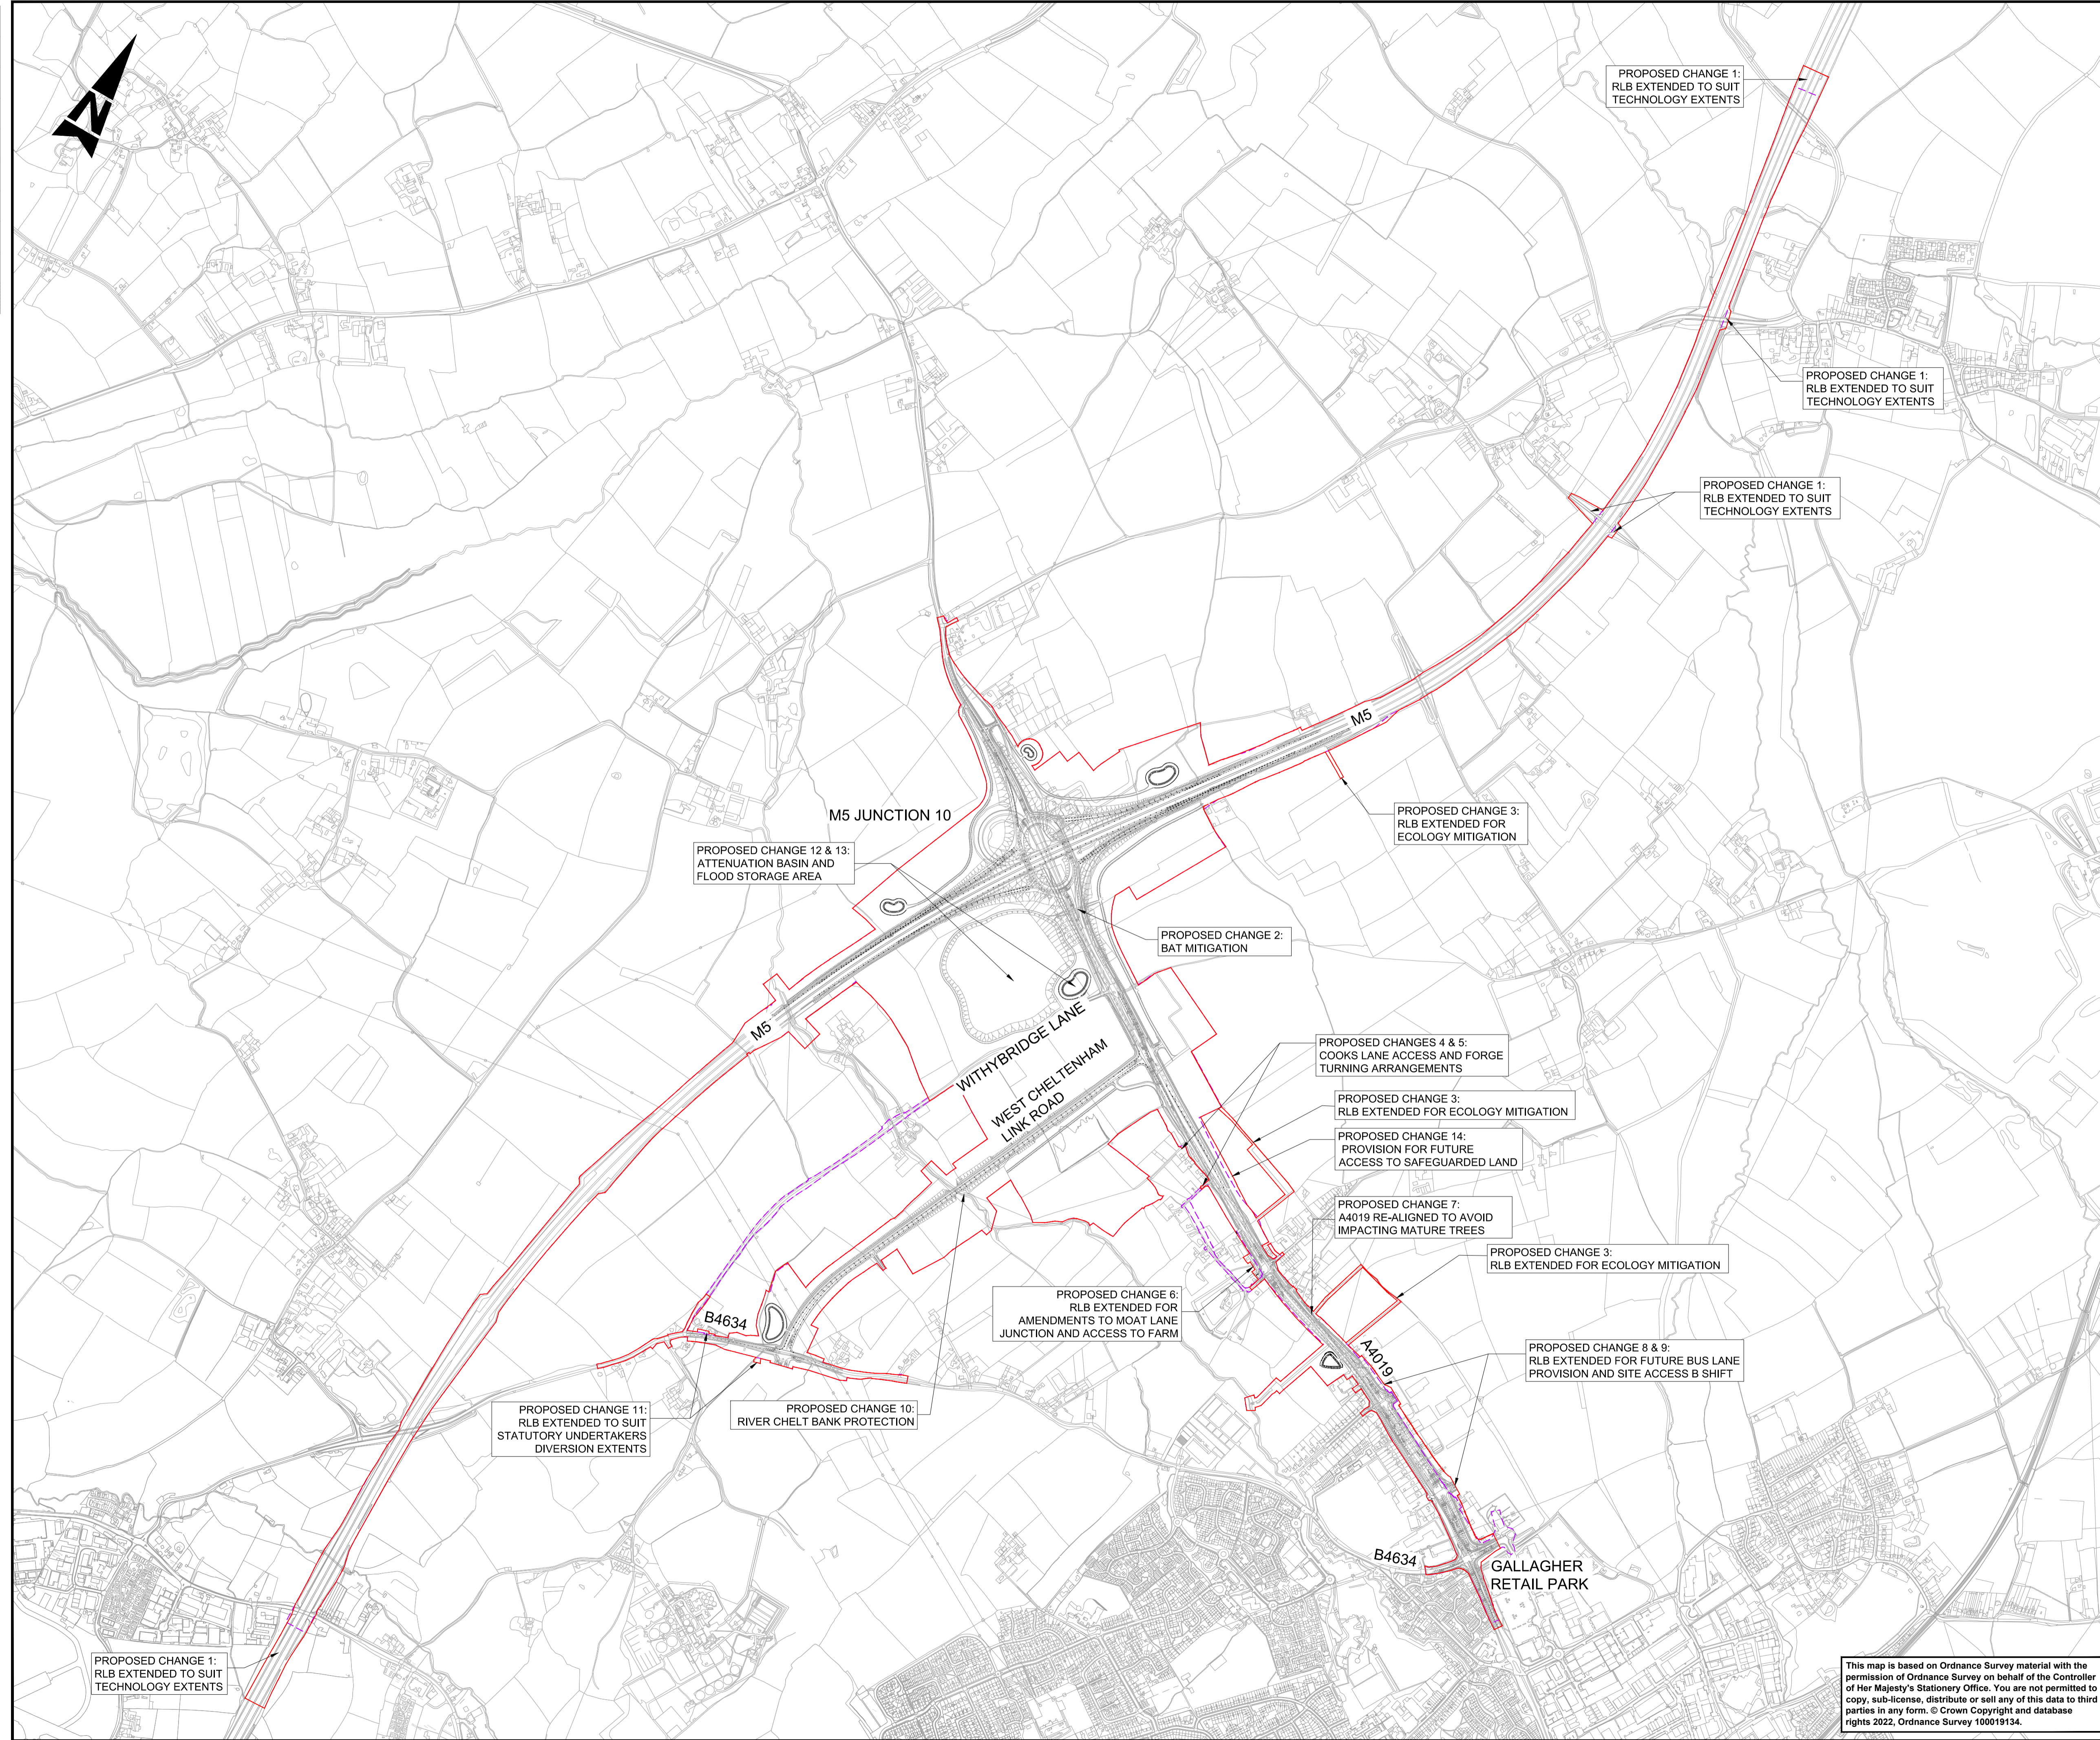


DO NOT SCALE

Millimetres
0 10 100

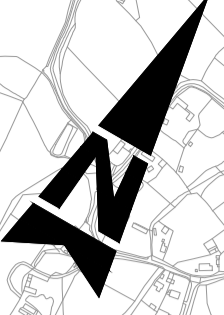

KEY:

- INDICATIVE APPLICATION RED LINE BOUNDARY (RLB) FOR TARGETED CONSULTATION
- - - INDICATIVE APPLICATION RED LINE BOUNDARY (RLB) FOR PUBLIC CONSULTATION

SAFETY, HEALTH AND ENVIRONMENTAL INFORMATION

In addition to the hazards/risks normally associated with the types of work detailed on this drawing, note the following significant residual risks (Reference shall also be made to the design hazard log).

Construction
Not identified at this stage
Maintenance / Cleaning
Not identified at this stage
Use
Not identified at this stage
Decommissioning / Demolition
Not identified at this stage

Status	Revision	Drawn	Checked	Reviewed	Authorised	Issue Date
Description						
Status	Revision	Drawn	Checked	Reviewed	Authorised	Issue Date
Description						
Status	Revision	Drawn	Checked	Reviewed	Authorised	Issue Date
Description						
Status	Revision	Drawn	Checked	Reviewed	Authorised	Issue Date
Description						

TARGET CONSULTATION

Status	Revision	Drawn	Checked	Reviewed	Authorised	Issue Date
A1	CO1	MC	NKRP	LJ	TT	03/08/22

Drawing Suitability: **APPROVED - PUBLISHED** Status: **A1**

ATKINS Member of the SNC-Lavalin Group
 5th Floor, Block 5
 Shire Hall
 Bearland
 Gloucester
 GL1 2TH
 Tel: 08000 514514

Copyright © Atkins Limited (2022)

Client: **Gloucestershire COUNTY COUNCIL**

Project Title: **M5 Junction 10 Improvements Scheme**

Drawing Title: **LAYOUT PLAN SHOWING LOCATIONS OF PROPOSED CHANGES FOR TARGETED CONSULTATION**

Project	Originator	Volume					
GCCM5J10	ATK	GEN					
ZZ	- DR - CH - 000005						
Location	Type	Role	Number				
A1	NTS						
Original Size	Scale	Project Ref. No.	Sheet	of	1	Rev.	C01

This map is based on Ordnance Survey material with the permission of Ordnance Survey on behalf of the Controller of Her Majesty's Stationery Office. You are not permitted to copy, sub-license, distribute or sell any of this data to third parties in any form. © Crown Copyright and database rights 2022, Ordnance Survey 100019134.