
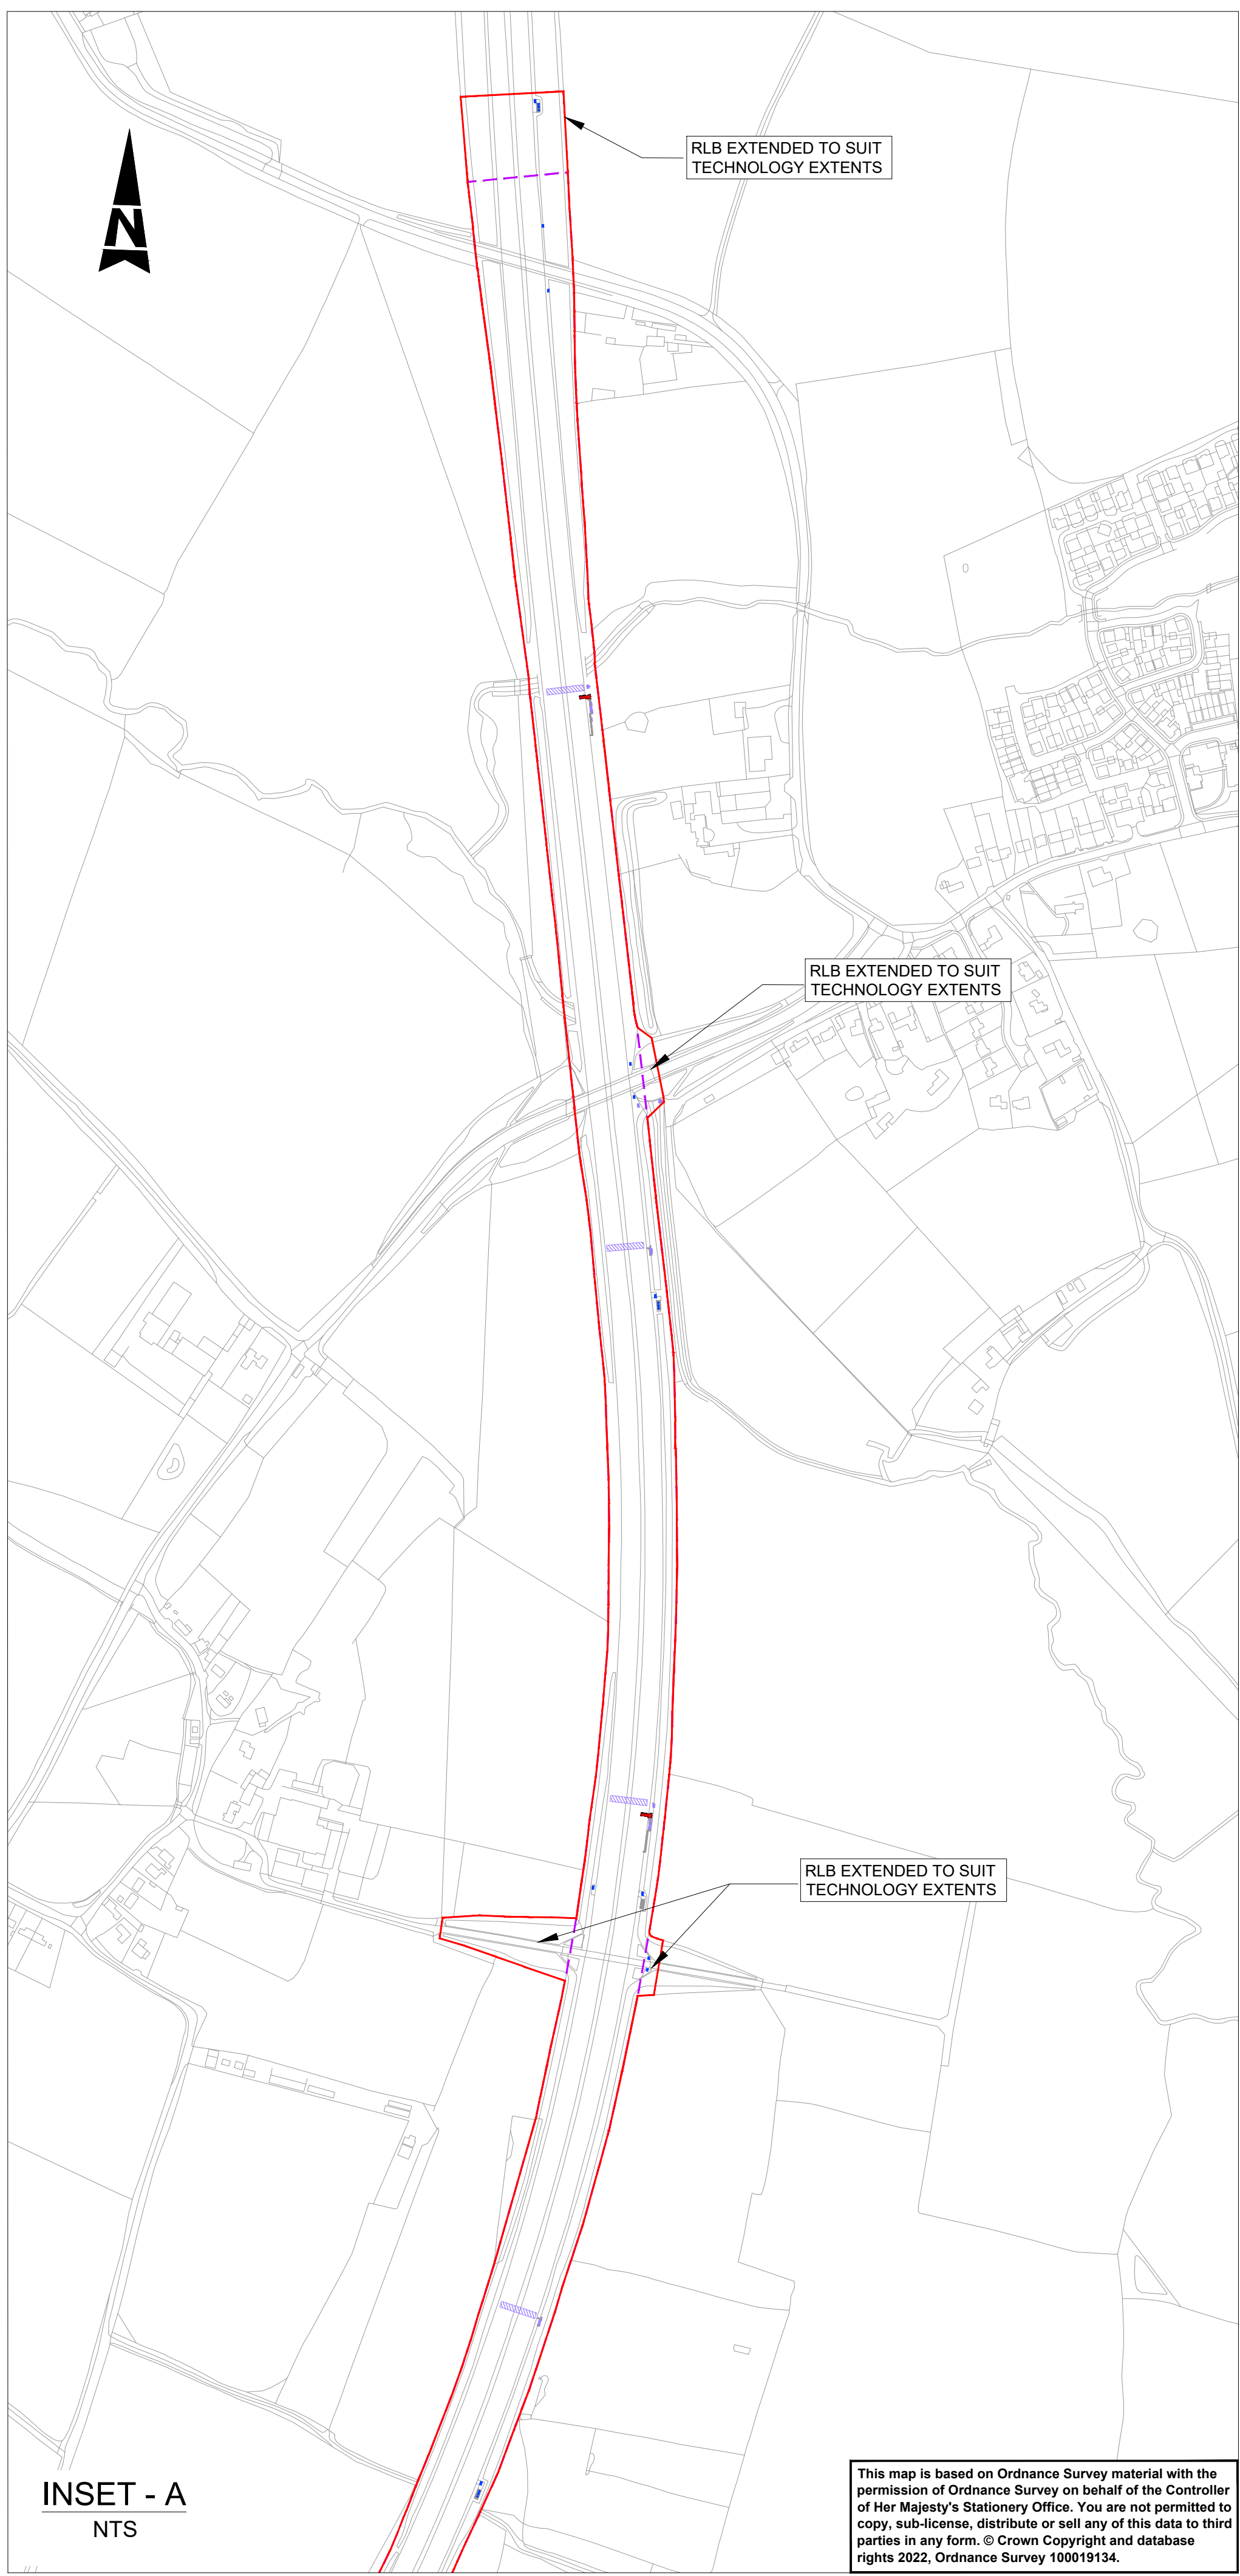


DO NOT SCALE

Millimetres

0 10 100

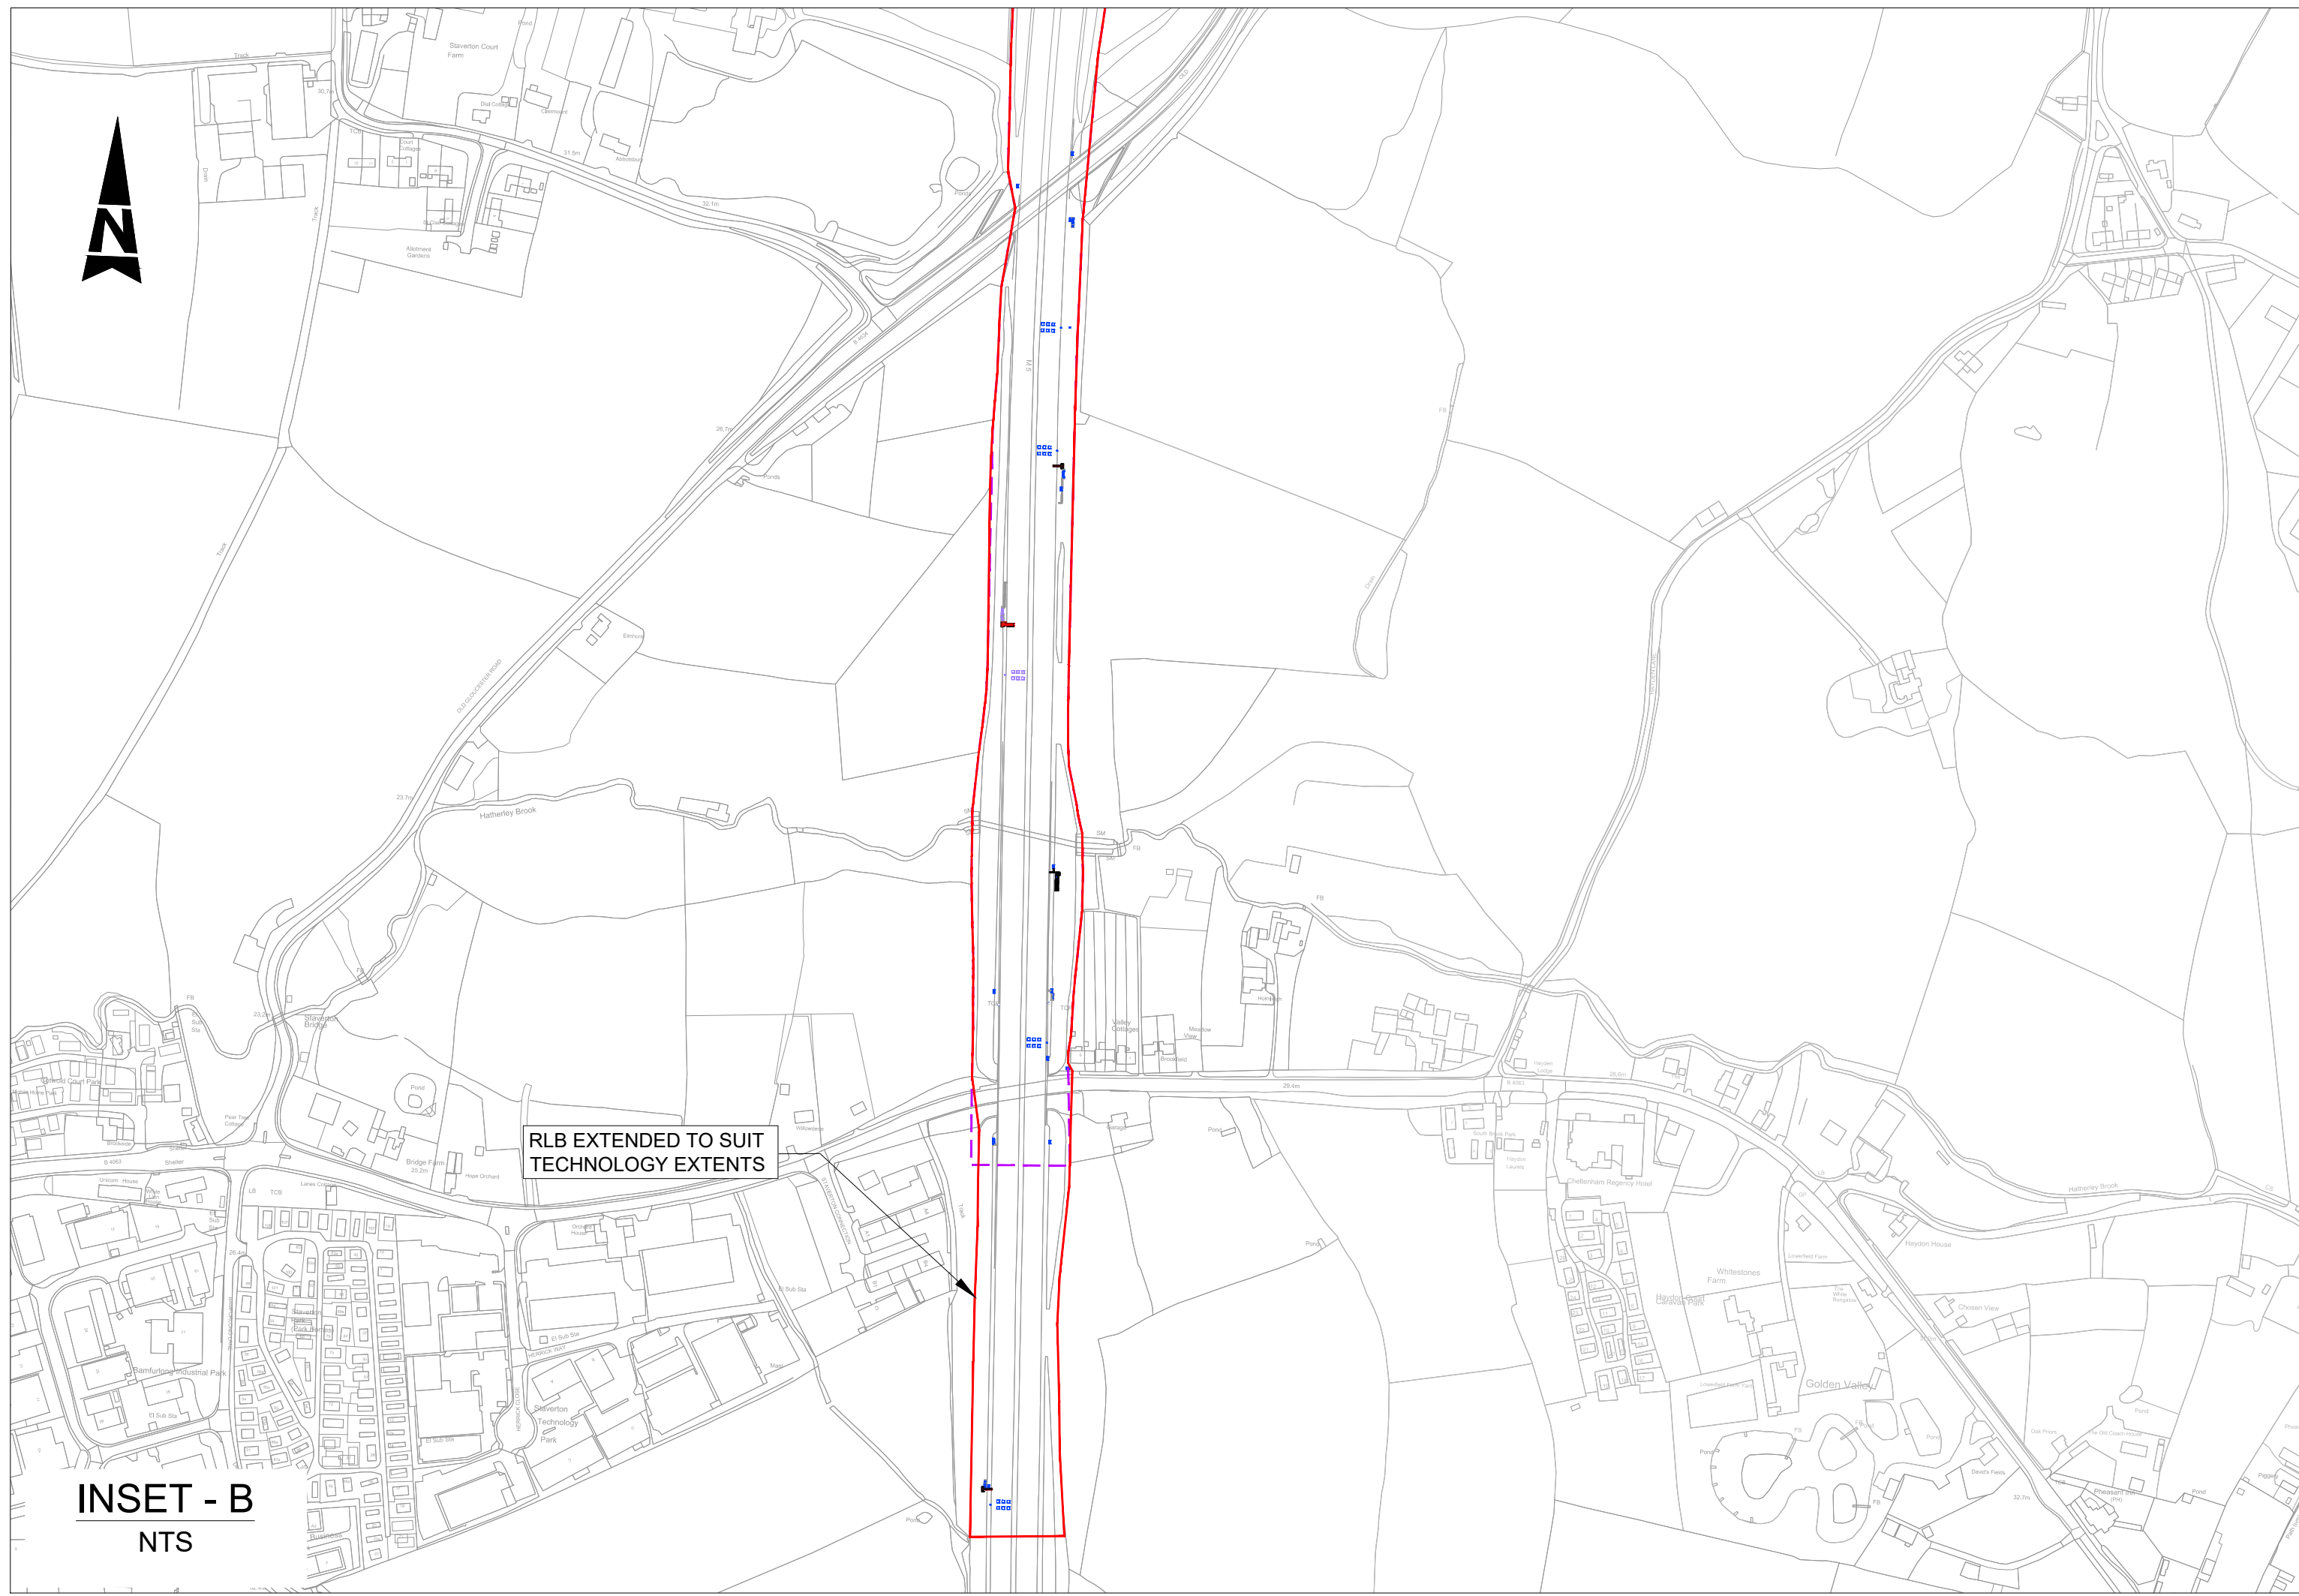

- KEY**
- INDICATIVE APPLICATION RED LINE BOUNDARY(RLB) FOR TARGETED CONSULTATION
 - INDICATIVE APPLICATION RED LINE BOUNDARY(RLB) FOR PUBLIC CONSULTATION
 - REMOVED TECHNOLOGY
 - RETAINED TECHNOLOGY
 - PROPOSED TECHNOLOGY
 - EXISTING GANTRY
 - PROPOSED GANTRY
 - PROPOSED MIDAS RADAR DETECTION FOOTPRINT
 - PROPOSED MIDAS LOOPS
 - RETAINED MIDAS LOOPS

SAFETY, HEALTH AND ENVIRONMENTAL INFORMATION

In addition to the hazards/risks normally associated with the types of work detailed on this drawing, note the following significant residual risks (Reference shall also be made to the design hazard log).

Construction
Not identified at this stage

Maintenance / Cleaning
Not identified at this stage

Use
Not identified at this stage

Decommissioning / Demolition
Not identified at this stage

Description

Status	Revision	Drawn	Checked	Reviewed	Authorised	Issue Date
--------	----------	-------	---------	----------	------------	------------

Description

Status	Revision	Drawn	Checked	Reviewed	Authorised	Issue Date
--------	----------	-------	---------	----------	------------	------------

Description

TARGET CONSULTATION

Status	Revision	Drawn	Checked	Reviewed	Authorised	Issue Date
--------	----------	-------	---------	----------	------------	------------

Description

Status	Revision	Drawn	Checked	Reviewed	Authorised	Issue Date
--------	----------	-------	---------	----------	------------	------------

Description

Status	Revision	Drawn	Checked	Reviewed	Authorised	Issue Date
--------	----------	-------	---------	----------	------------	------------

APPROVED - PUBLISHED

A1

ATKINS

Member of the SNC-Lavalin Group

5th Floor, Block 5
Shire Hall
Bearland
Gloucester
GL1 2TH

Tel : 08000 514514

Copyright © Atkins Limited (2022)

Client

Gloucestershire

COUNTY COUNCIL

Project Title

M5 Junction 10 Improvements Scheme

Drawing Title

PROPOSED CHANGE 1
MOTORWAY TECHNOLOGY
EXTENT INCREASED

Drawing Number

Project

GCCM5J10 - ATK - GEN -

ZZ - DR - CH - 000006

Location

A1

Scale: NTS

Project Ref. No. 5197035

Sheet: 1 of 1

Rev. C01

This map is based on Ordnance Survey material with the permission of Ordnance Survey on behalf of the Controller of Her Majesty's Stationery Office. You are not permitted to copy, sub-license, distribute or sell any of this data to third parties in any form. © Crown Copyright and database rights 2022, Ordnance Survey 100019134.