


DO NOT SCALE


Millimetres

0 10 100

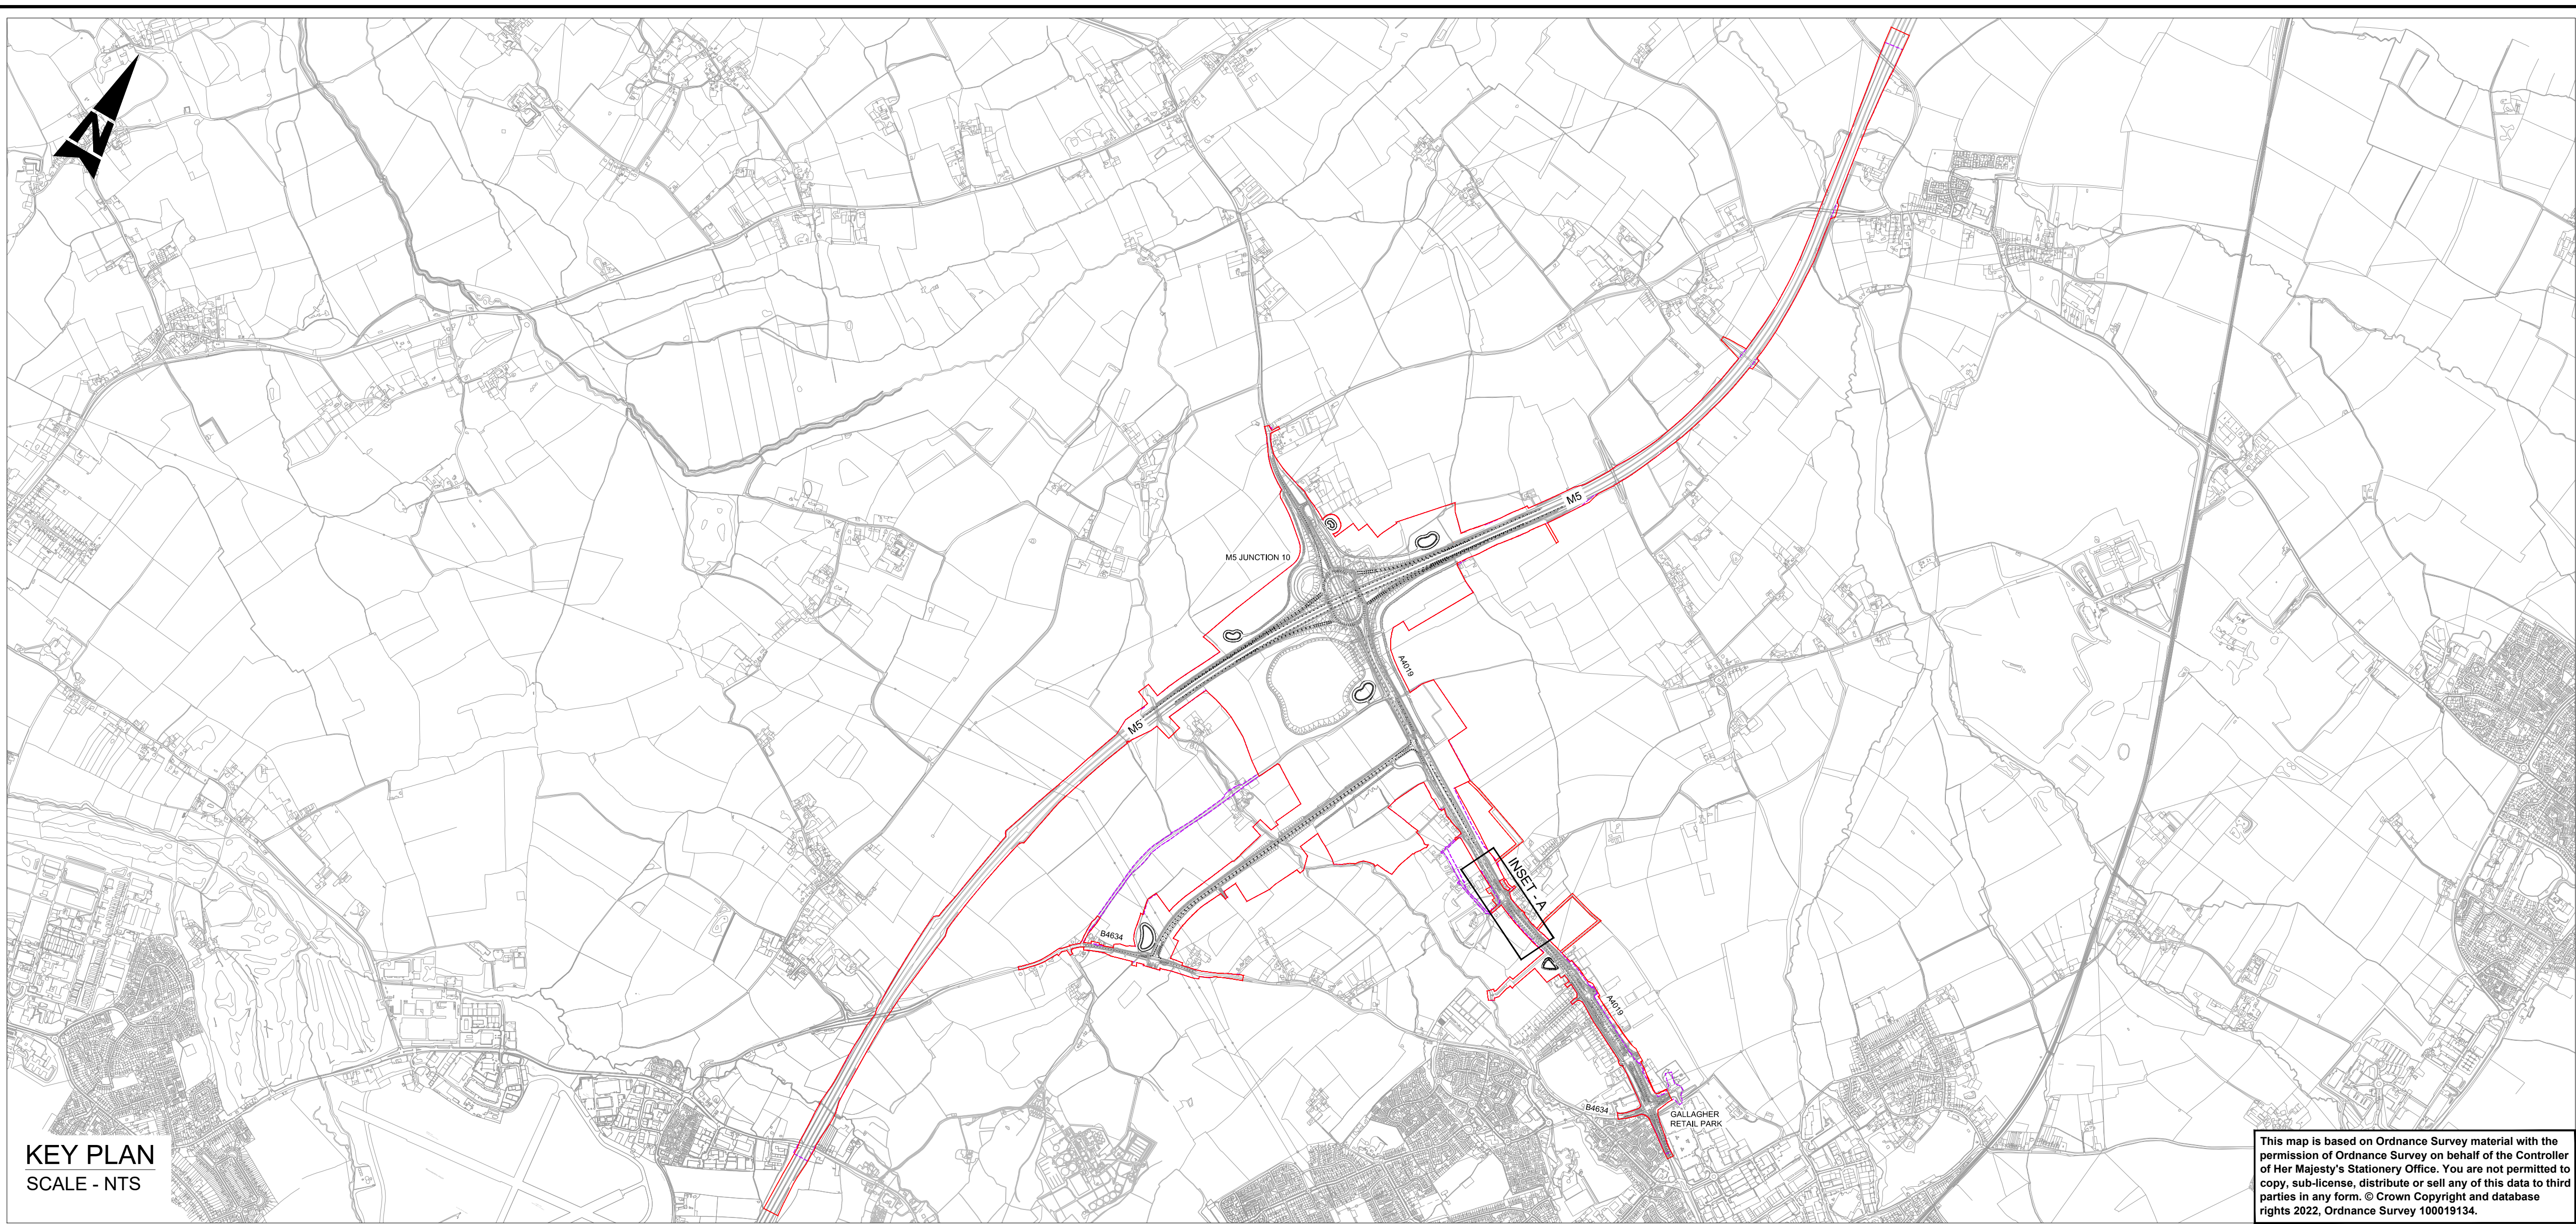

KEY PLAN
SCALE - NTS

This map is based on Ordnance Survey material with the permission of Ordnance Survey on behalf of the Controller of Her Majesty's Stationery Office. You are not permitted to copy, sub-license, distribute or sell any of this data to third parties in any form. © Crown Copyright and database rights 2022, Ordnance Survey 100019134.

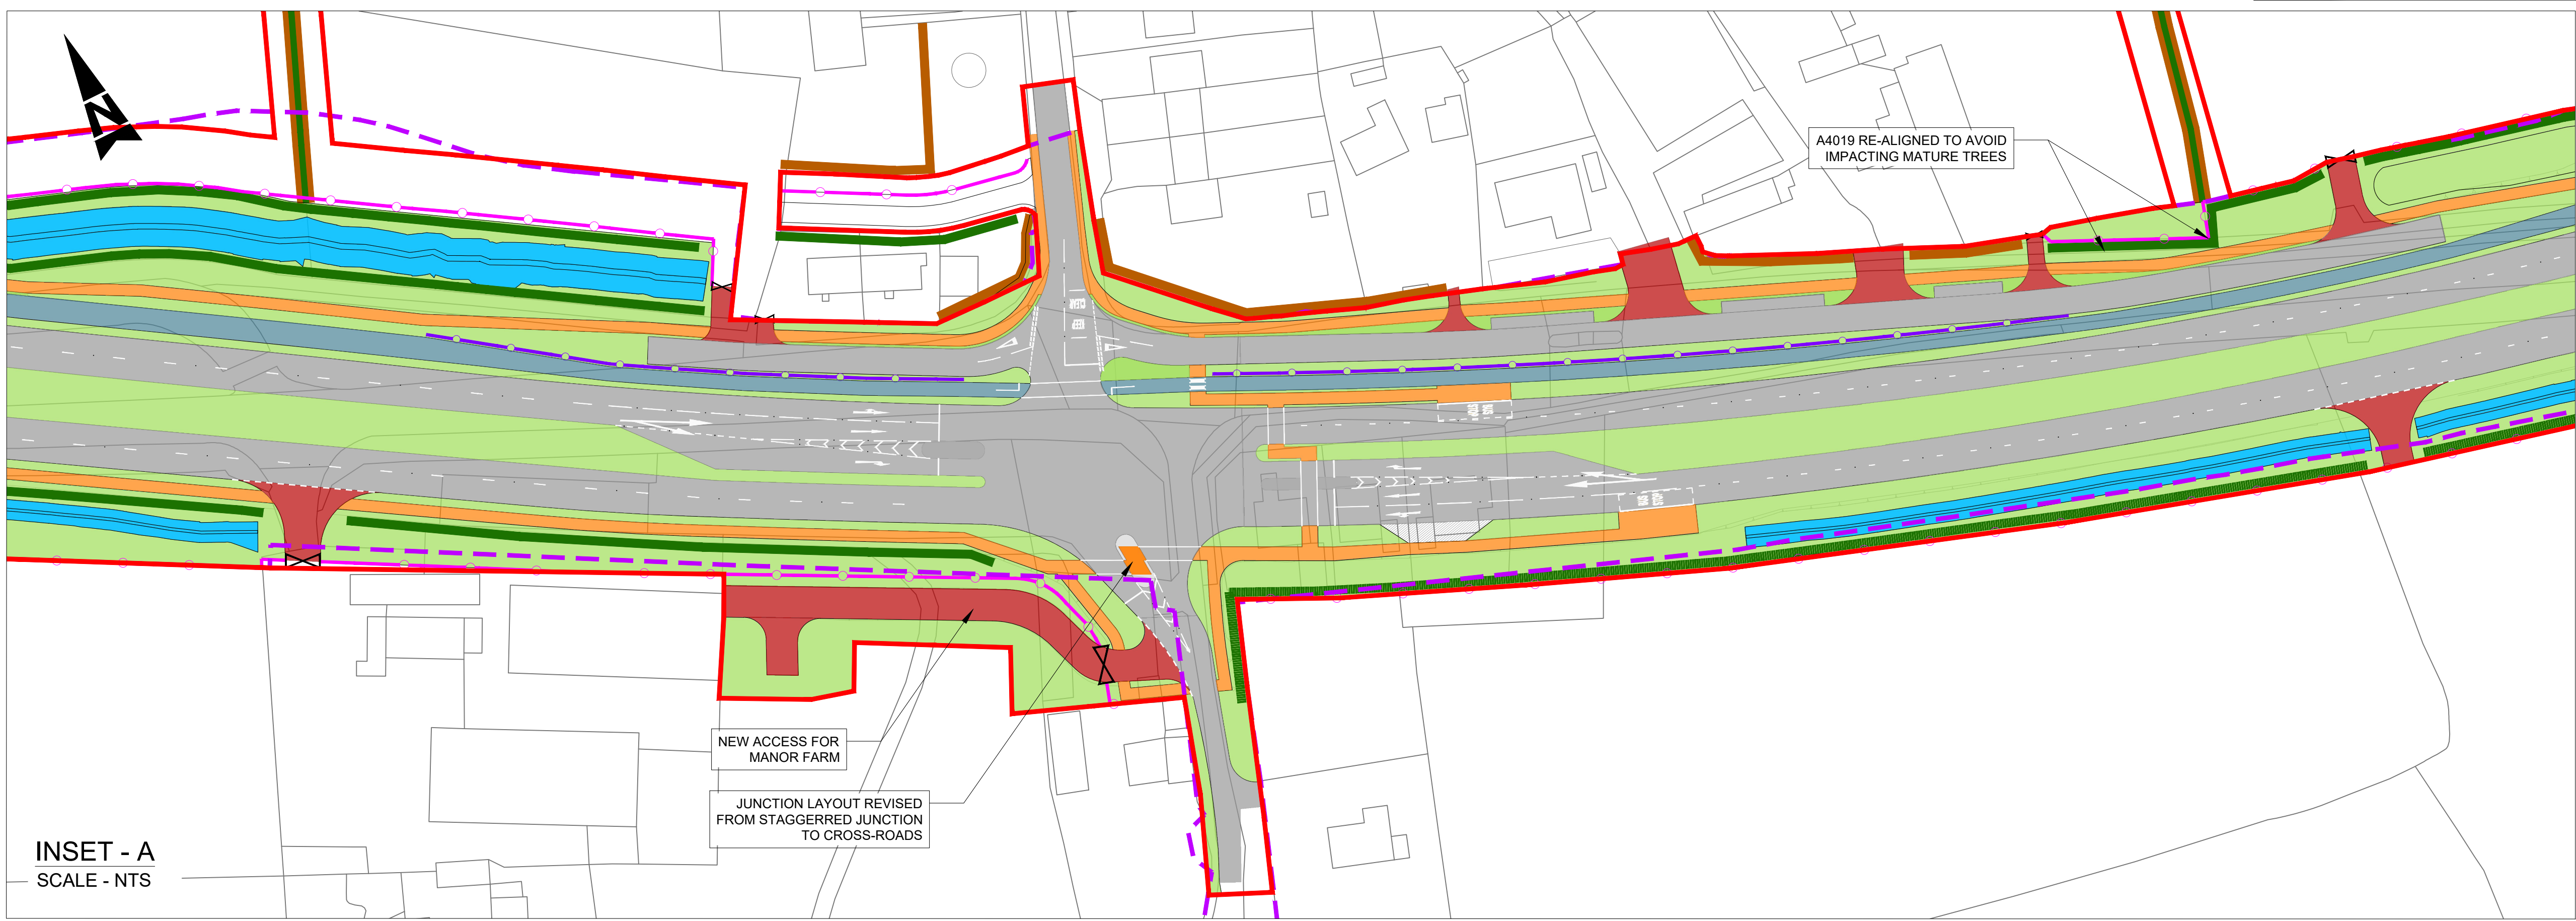

INSET - A
SCALE - NTS

KEY :

- INDICATIVE APPLICATION RED LINE BOUNDARY (RLB) FOR TARGETED CONSULTATION
- INDICATIVE APPLICATION RED LINE BOUNDARY (RLB) FOR PUBLIC CONSULTATION
- PROPOSED HIGHWAY FENCING
- PROPOSED REFLECTIVE NOISE BARRIER 2m HIGH
- PROPOSED GATE
- PROPOSED OVERBRIDGE
- PROPOSED UNDERBRIDGE/CULVERT
- PROPOSED CARRIAGEWAY
- PROPOSED FOOTWAY
- PROPOSED CYCLE TRACK
- PROPOSED SHARED USE PATH
- PROPOSED ACCESS TRACK
- PROPOSED ISLAND
- EXISTING HEDGEROW - TO BE RETAINED
- EXISTING HEDGEROW - TO BE ENHANCED
- PROPOSED VEGETATION
- WATER BODIES/ DITCHES

SAFETY, HEALTH AND ENVIRONMENTAL INFORMATION

In addition to the hazards/risks normally associated with the types of work detailed on this drawing, note the following significant residual risks (Reference shall also be made to the design hazard log).

Construction

Not identified at this stage

Maintenance / Cleaning

Not identified at this stage

Use

Not identified at this stage

Decommissioning / Demolition

Not identified at this stage

Description

Status	Revision	Drawn	Checked	Reviewed	Authorised	Issue Date
--------	----------	-------	---------	----------	------------	------------

Description

Status	Revision	Drawn	Checked	Reviewed	Authorised	Issue Date
--------	----------	-------	---------	----------	------------	------------

Description

Status	Revision	Drawn	Checked	Reviewed	Authorised	Issue Date
--------	----------	-------	---------	----------	------------	------------

Description

Status	Revision	Drawn	Checked	Reviewed	Authorised	Issue Date
--------	----------	-------	---------	----------	------------	------------

Description

TARGET CONSULTATION

Status	Revision	Drawn	Checked	Reviewed	Authorised	Issue Date
--------	----------	-------	---------	----------	------------	------------

Drawing Suitability

Status	Revision	Drawn	Checked	Reviewed	Authorised	Issue Date
--------	----------	-------	---------	----------	------------	------------

APPROVED - PUBLISHED

A1

ATKINS
Member of the SNC-Lavalin Group

5th Floor, Block 5
Shire Hall
Bearland
Gloucester
GL1 2TH
Tel : 08000 514514

Copyright © Atkins Limited (2022)

Client



Project Title

M5 Junction 10 Improvements Scheme

Drawing Title

PROPOSED CHANGES 6 AND 7
CHANGE TO UCKINGTON JUNCTION
AND REALIGNMENT OF A4019
EAST OF JUNCTION

Drawing Number

Project
GCCM5J10 - ATK - GEN -
ZZ - DR - CH - 000010

Location

Original Size	Scale	Project Ref. No.	Sheet	Rev.
---------------	-------	------------------	-------	------

A1

Scale: NTS

Project Ref. No.

5197035

Sheet: 1

of 1

Rev: C01