



DO NOT SCALE
 0 10 100
 Millimetres

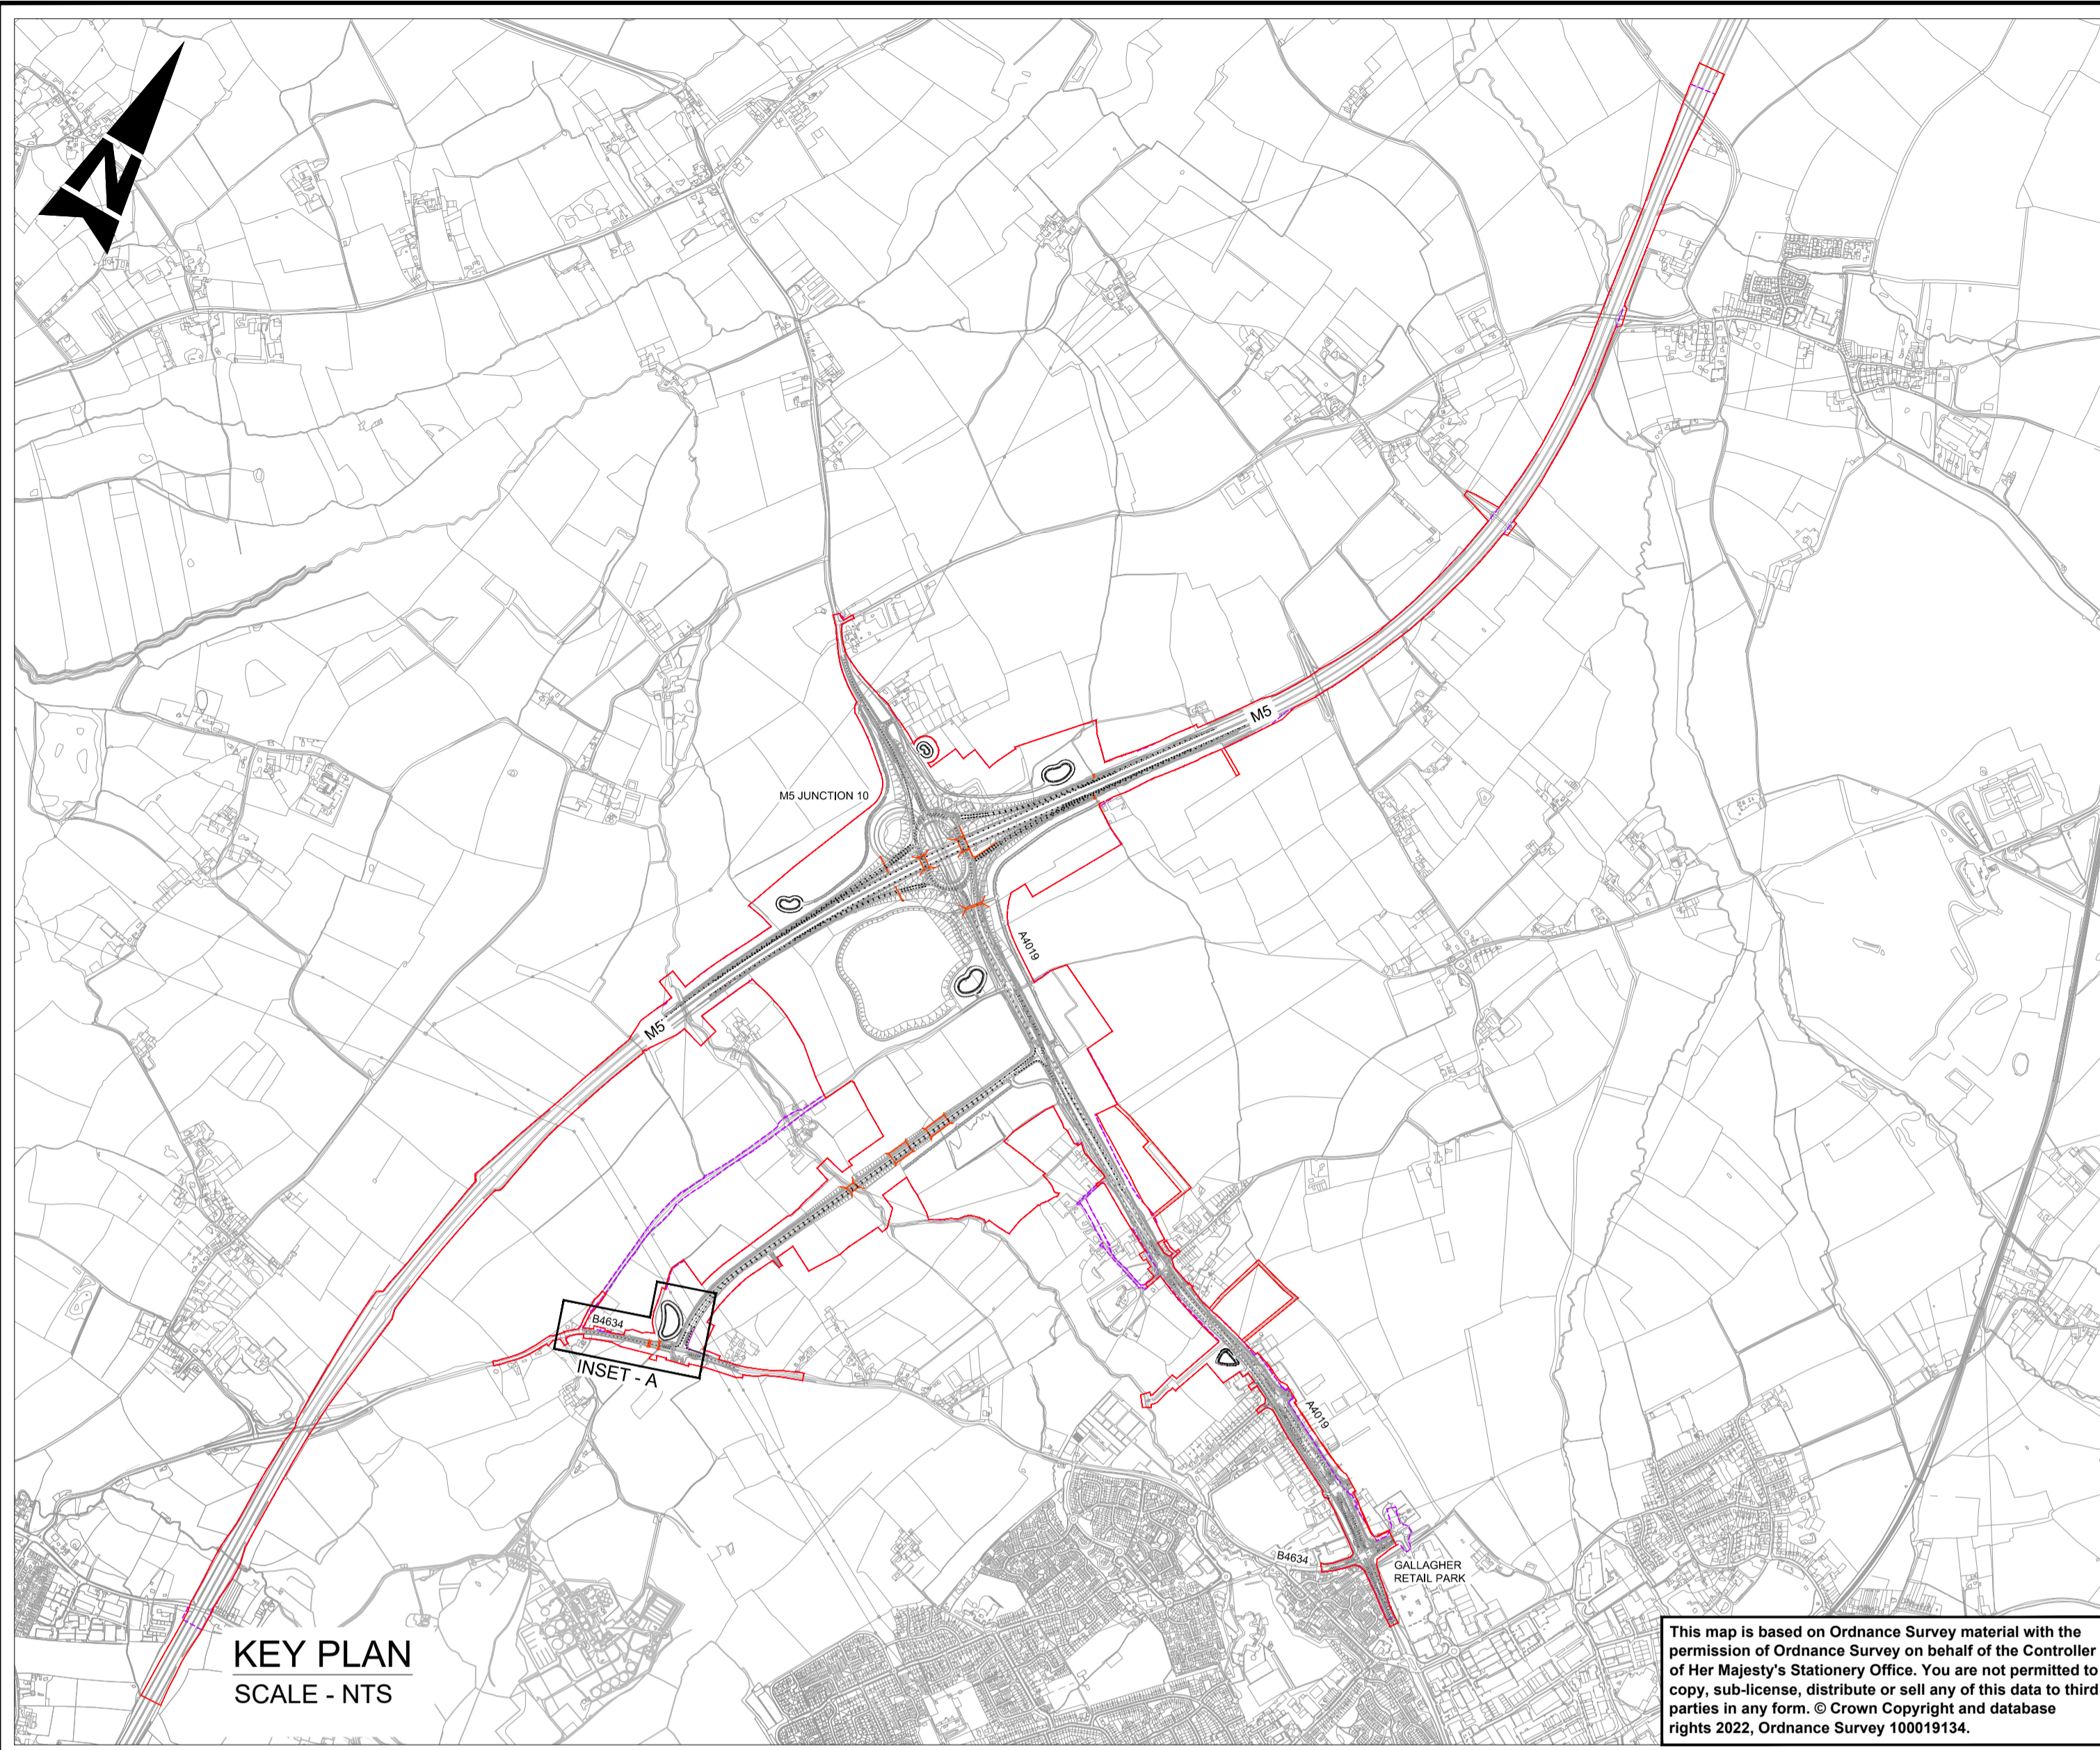

KEY PLAN
 SCALE - NTS

This map is based on Ordnance Survey material with the permission of Ordnance Survey on behalf of the Controller of Her Majesty's Stationery Office. You are not permitted to copy, sub-license, distribute or sell any of this data to third parties in any form. © Crown Copyright and database rights 2022, Ordnance Survey 100019134.

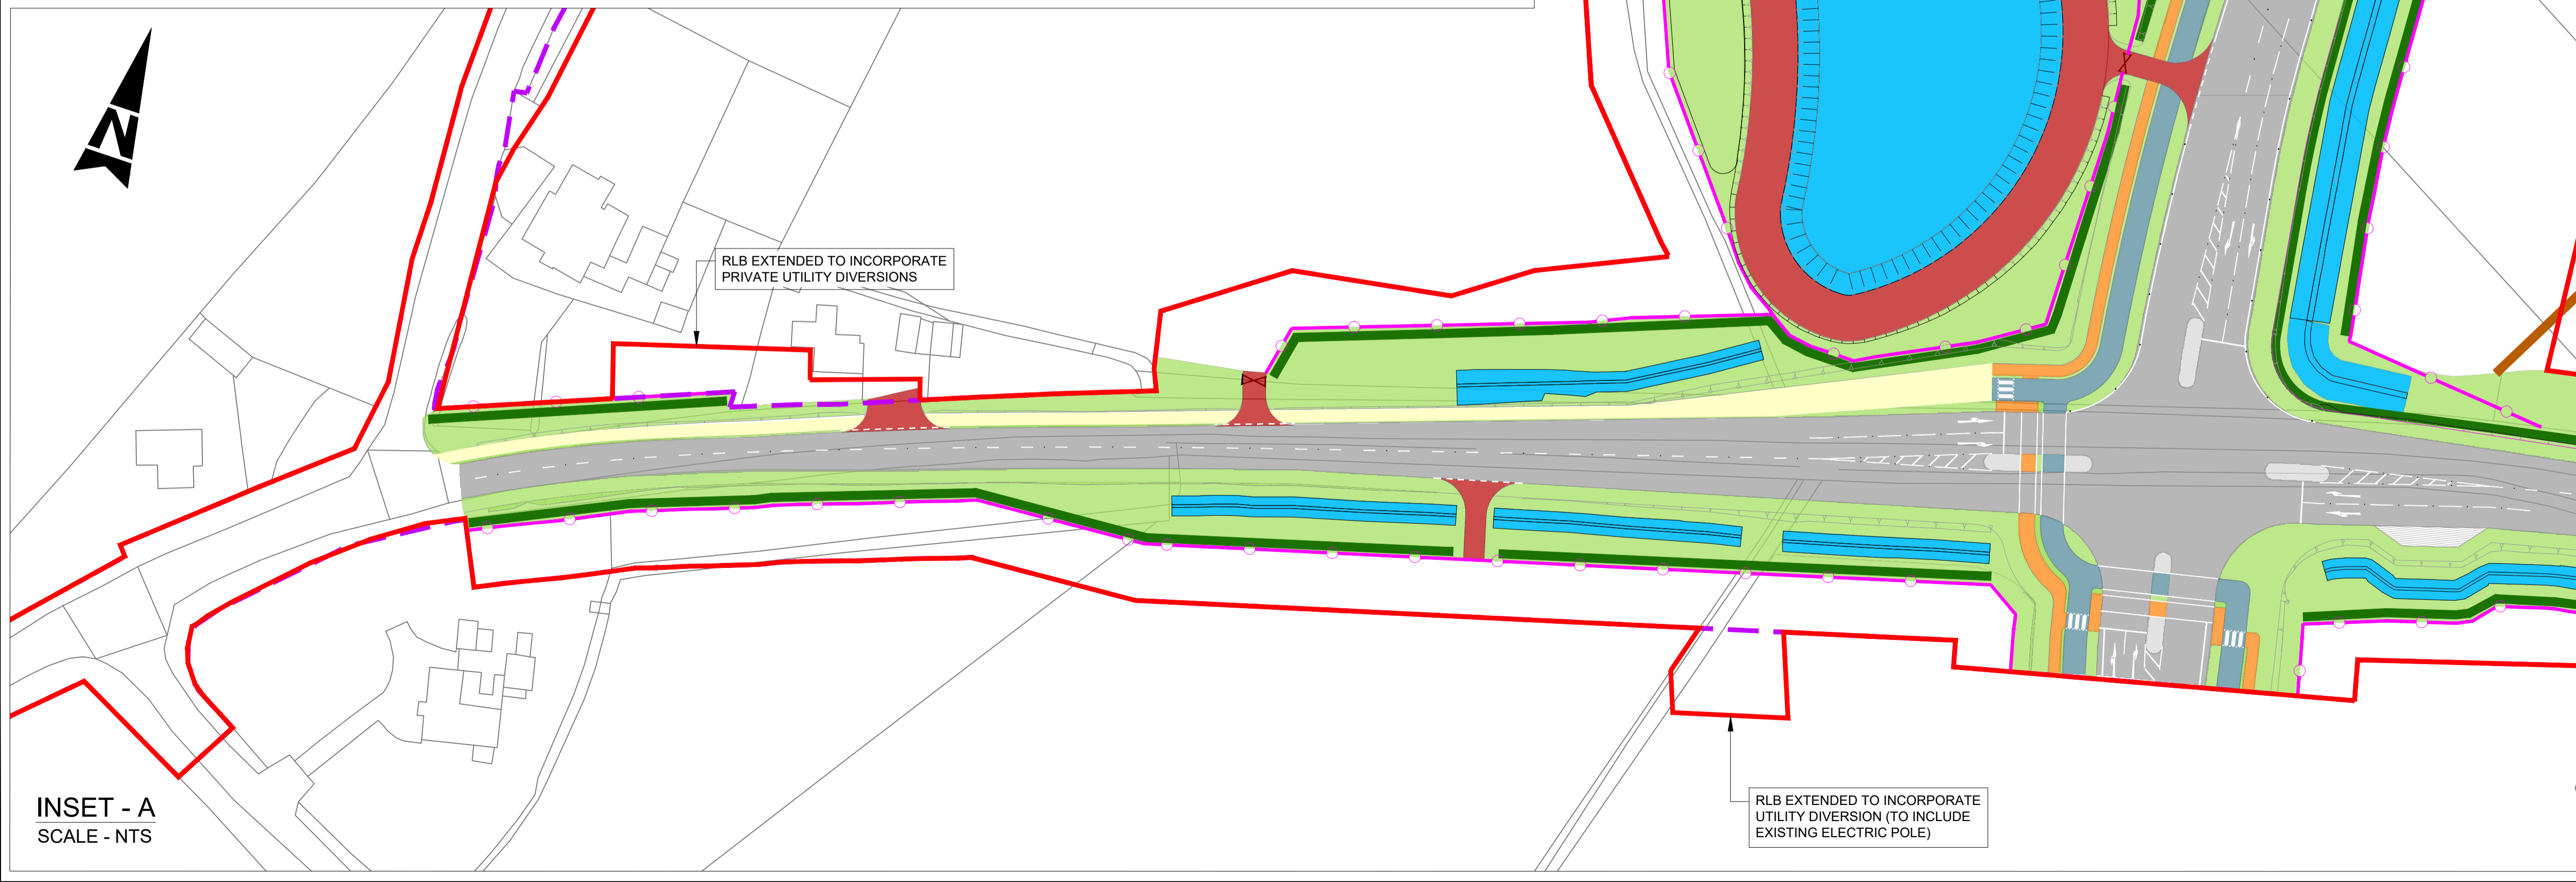

INSET - A
 SCALE - NTS

RLB EXTENDED TO INCORPORATE UTILITY DIVERSION (TO INCLUDE EXISTING ELECTRIC POLE)

KEY :

- INDICATIVE APPLICATION RED LINE BOUNDARY (RLB) FOR TARGETED CONSULTATION
- INDICATIVE APPLICATION RED LINE BOUNDARY (RLB) FOR PUBLIC CONSULTATION
- PROPOSED HIGHWAY FENCING
- PROPOSED REFLECTIVE NOISE BARRIER 2m HIGH
- ∇ PROPOSED GATE
- PROPOSED OVERBRIDGE
- PROPOSED UNDERBRIDGE/CULVERT
- PROPOSED CARRIAGEWAY
- PROPOSED FOOTWAY
- PROPOSED CYCLE TRACK
- PROPOSED SHARED USE PATH
- PROPOSED ACCESS TRACK
- PROPOSED ISLAND
- EXISTING HEDGEROW - TO BE RETAINED
- EXISTING HEDGEROW - TO BE ENHANCED
- PROPOSED VEGETATION
- WATER BODIES/ DITCHES

SAFETY, HEALTH AND ENVIRONMENTAL INFORMATION

In addition to the hazards/risks normally associated with the types of work detailed on this drawing, note the following significant residual risks (Reference shall also be made to the design hazard log).

Construction
Not identified at this stage
Maintenance / Cleaning
Not identified at this stage
Use
Not identified at this stage
Decommissioning / Demolition
Not identified at this stage

Description	Status	Revision	Drawn	Checked	Reviewed	Authorised	Issue Date

TARGET CONSULTATION

Description	Status	Revision	Drawn	Checked	Reviewed	Authorised	Issue Date

Drawing Suitability	APPROVED - PUBLISHED	Status
		A1

ATKINS
 Member of the SNC-Lavalin Group

5th Floor, Block 5
 Shire Hall
 Bearland
 Gloucester
 GL1 2TH
 Tel : 08000 514514

Copyright © Atkins Limited (2022)

Client

gloucestershire
 COUNTY COUNCIL

Project Title
M5 Junction 10 Improvements Scheme

Drawing Title
**PROPOSED CHANGE 11
 STATUTORY UNDERTAKERS DIVERSIONS
 EXTENTS INCREASED**

Drawing Number	Project	Originator	Volume
GCCM5J10	ZZ	ATK	GEN
		DR - CH - 000013	
Location	Type	Role	Number
A1	NTS	5197035	Sheet: 1 of 1
Original Size	Scale	Project Ref. No.	Rev.
A1	NTS	5197035	C01