
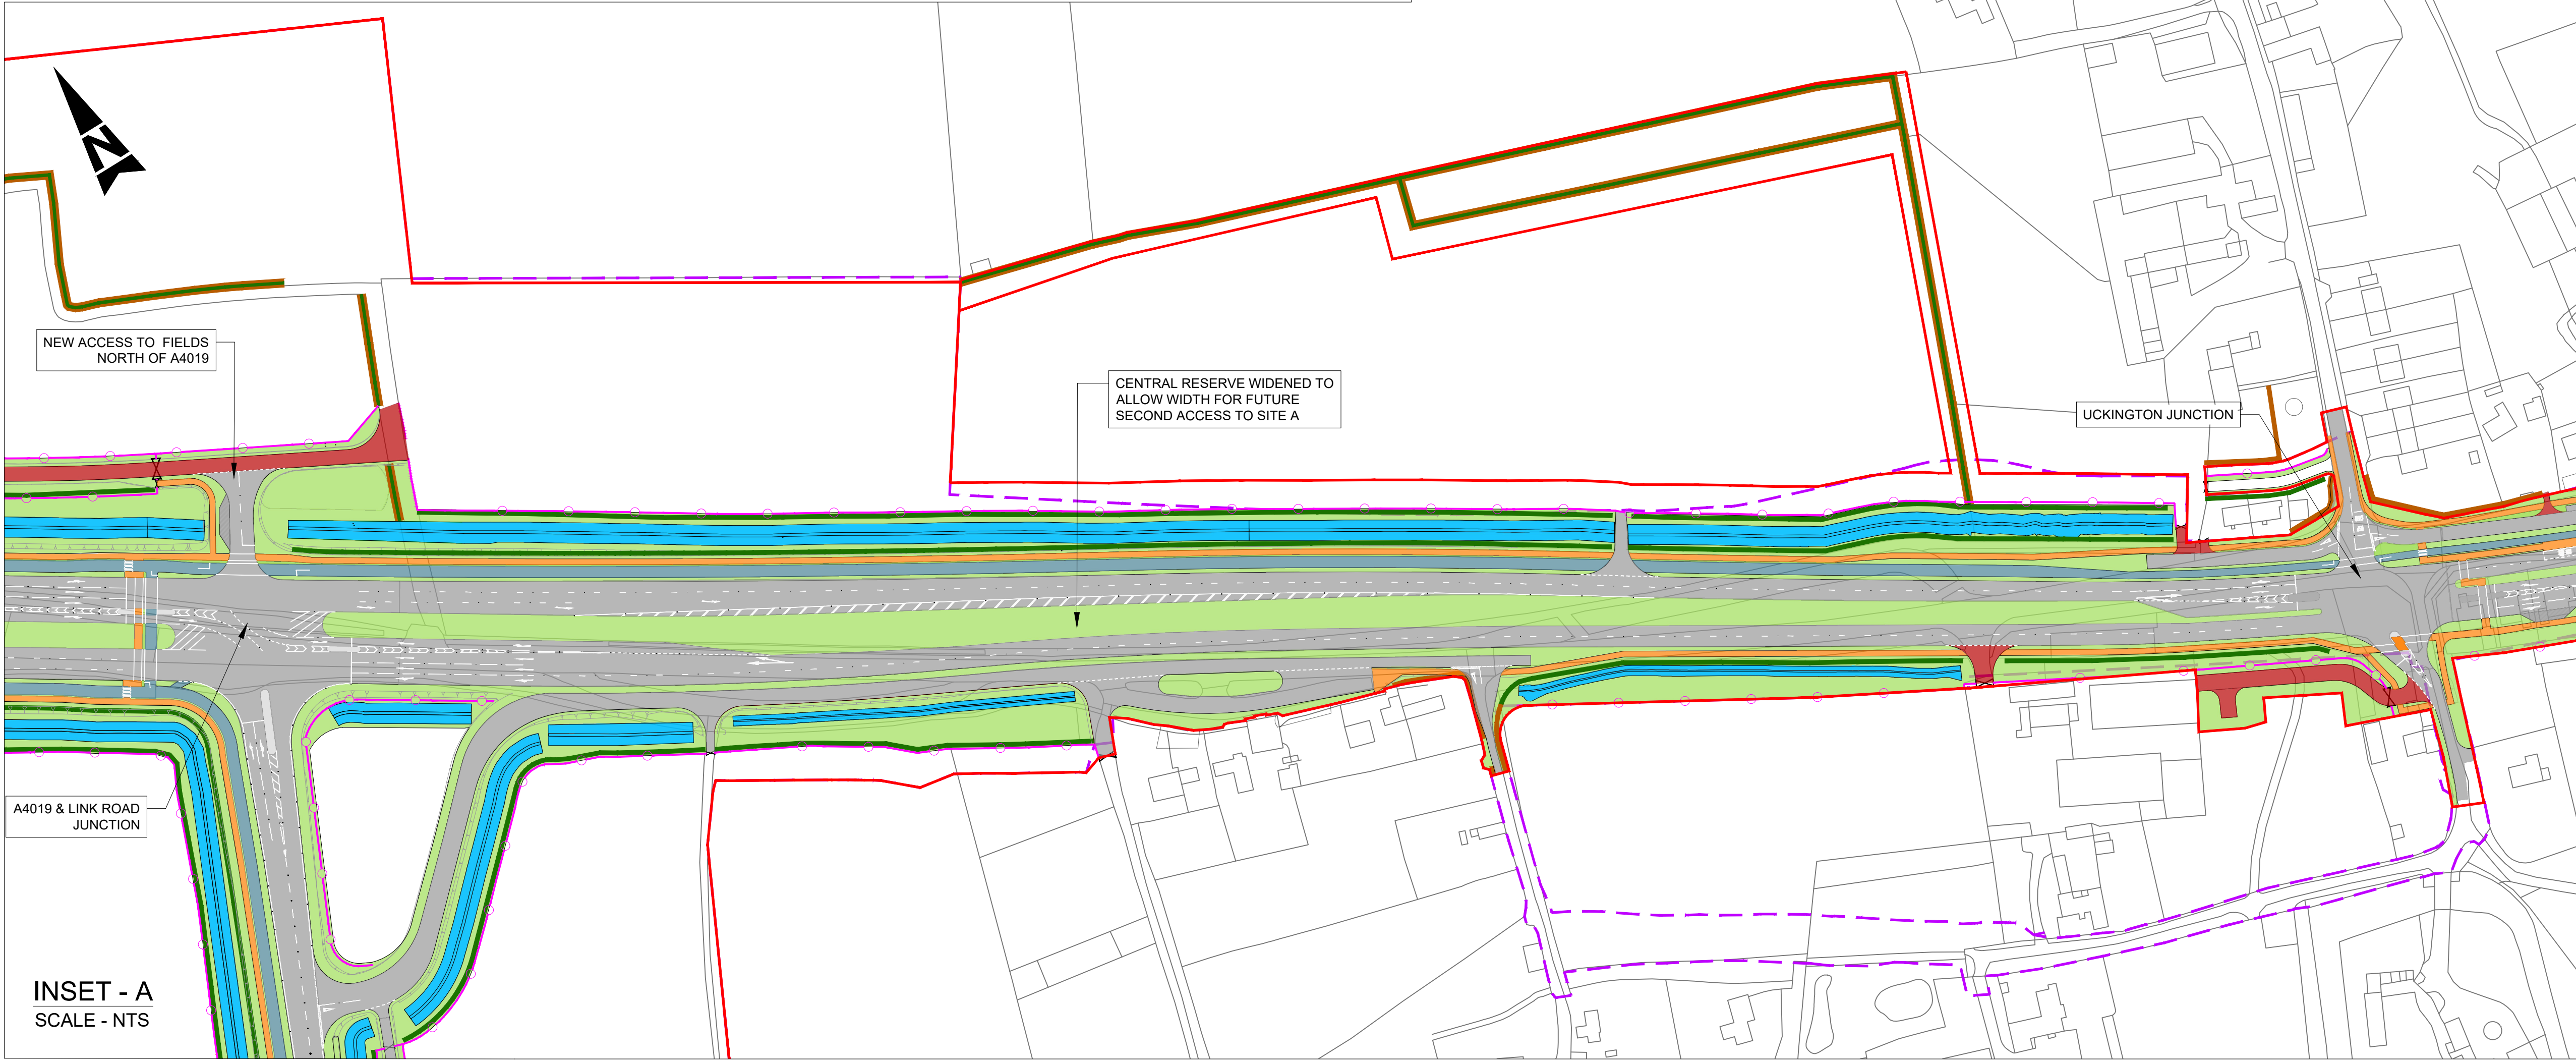


DO NOT SCALE

Millimetres

0 10 100

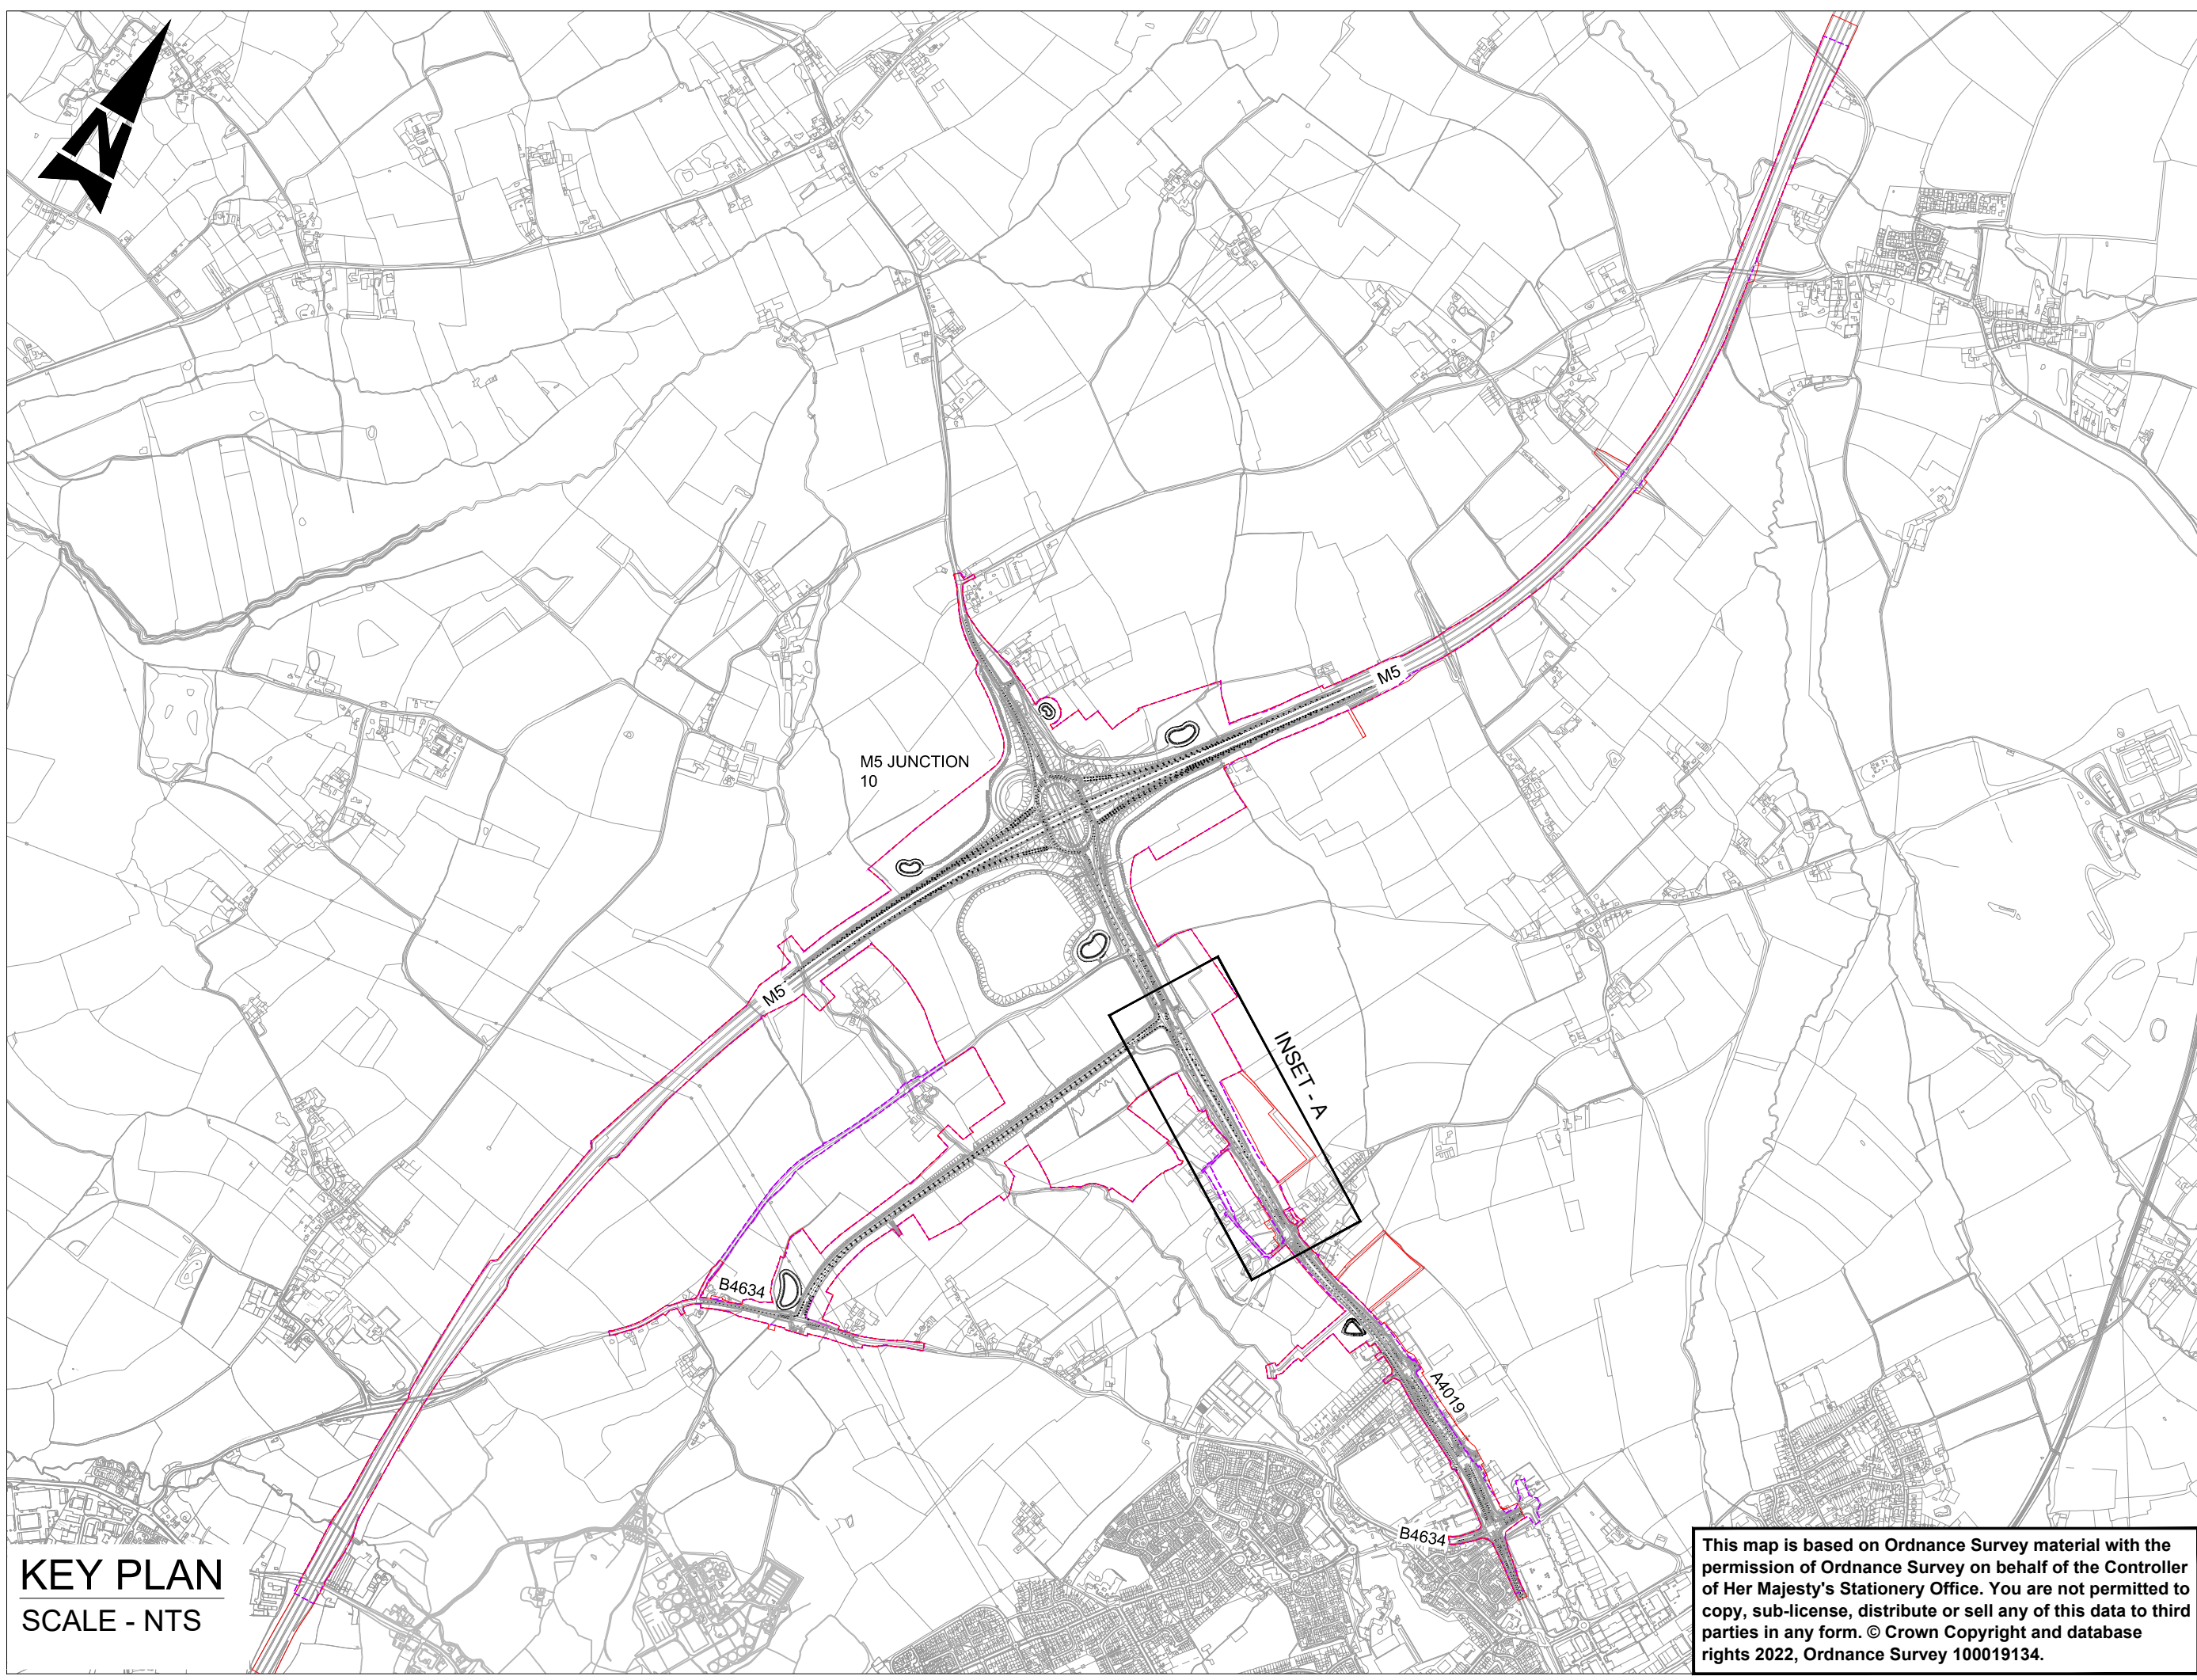

- KEY :
- INDICATIVE APPLICATION RED LINE BOUNDARY (RLB) FOR TARGETED CONSULTATION
 - INDICATIVE APPLICATION RED LINE BOUNDARY (RLB) FOR PUBLIC CONSULTATION
 - PROPOSED HIGHWAY FENCING
 - PROPOSED REFLECTIVE NOISE BARRIER 2m HIGH
 - PROPOSED GATE
 - PROPOSED OVERBRIDGE
 - PROPOSED UNDERBRIDGE/CULVERT
 - PROPOSED CARRIAGEWAY
 - PROPOSED FOOTWAY
 - PROPOSED CYCLE TRACK
 - PROPOSED SHARED USE PATH
 - PROPOSED ACCESS TRACK
 - PROPOSED ISLAND
 - EXISTING HEDGEROW - TO BE RETAINED
 - EXISTING HEDGEROW - TO BE ENHANCED
 - PROPOSED VEGETATION
 - WATER BODIES/ DITCHES

SAFETY, HEALTH AND ENVIRONMENTAL INFORMATION

In addition to the hazards/risks normally associated with the types of work detailed on this drawing, note the following significant residual risks (Reference shall also be made to the design hazard log).

Construction

Not identified at this stage

Maintenance / Cleaning

Not identified at this stage

Use

Not identified at this stage

Decommissioning / Demolition

Not identified at this stage

Description

Status	Revision	Drawn	Checked	Reviewed	Authorised	Issue Date
--------	----------	-------	---------	----------	------------	------------

Description

Status	Revision	Drawn	Checked	Reviewed	Authorised	Issue Date
--------	----------	-------	---------	----------	------------	------------

Description

Status	Revision	Drawn	Checked	Reviewed	Authorised	Issue Date
--------	----------	-------	---------	----------	------------	------------

Description

Status	Revision	Drawn	Checked	Reviewed	Authorised	Issue Date
--------	----------	-------	---------	----------	------------	------------

Description

TARGET CONSULTATION

Status	Revision	Drawn	Checked	Reviewed	Authorised	Issue Date
A1	CO1	MC	NKRP	LJ	TT	03/08/22

Drawing Suitability

A1

APPROVED - PUBLISHED

A1

ATKINS

Member of the SNC-Lavalin Group

5th Floor, Block 5
Shire Hall
Bearland
Gloucester
GL1 2TH
Tel : 08000 514514

Copyright © Atkins Limited (2022)

Client



Project Title
M5 Junction 10 Improvements Scheme

Drawing Title
PROPOSED CHANGE 14
REVISED PROVISION FOR ACCESS
TO SAFEGUARDED LAND (SITE A)

Drawing Number Project GCCM5J10 ZZ	Originator ATK	Volume GEN	
Location	Type	Role	Number
Original Size: A1	Scale: NTS	Project Ref. No. 5197035	Sheet: 1 of 1
		Rev: C01	