
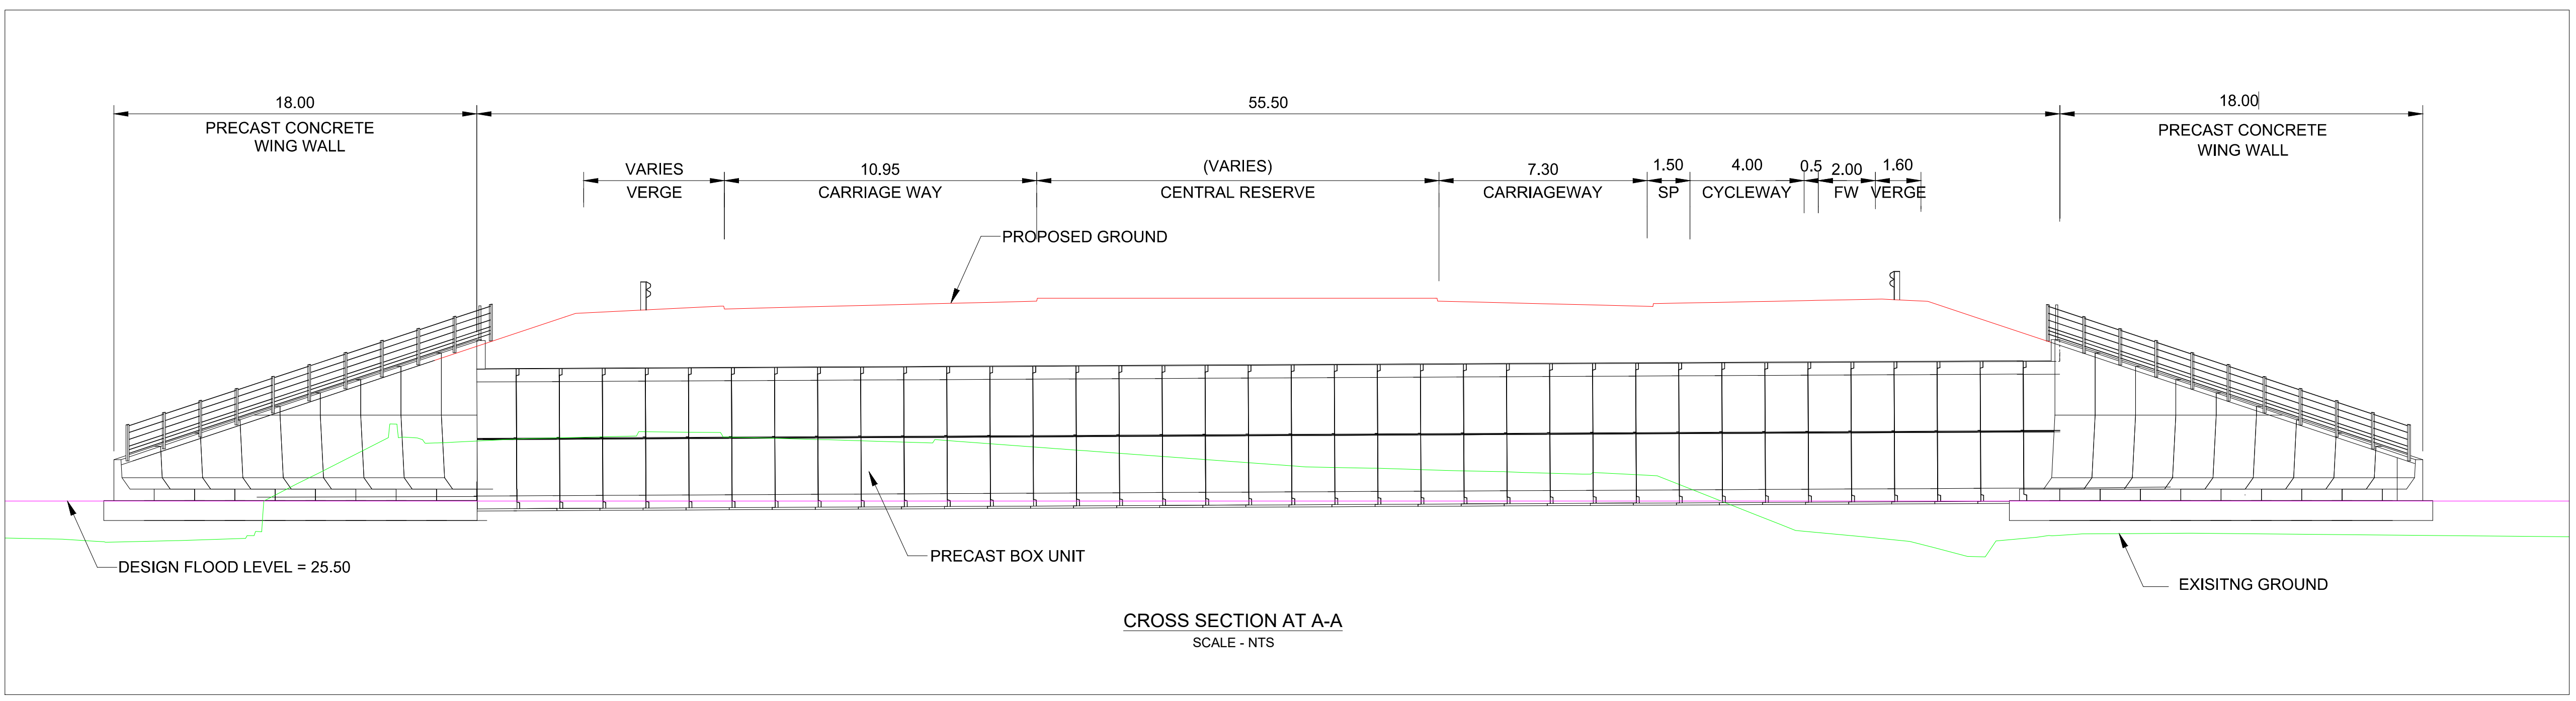
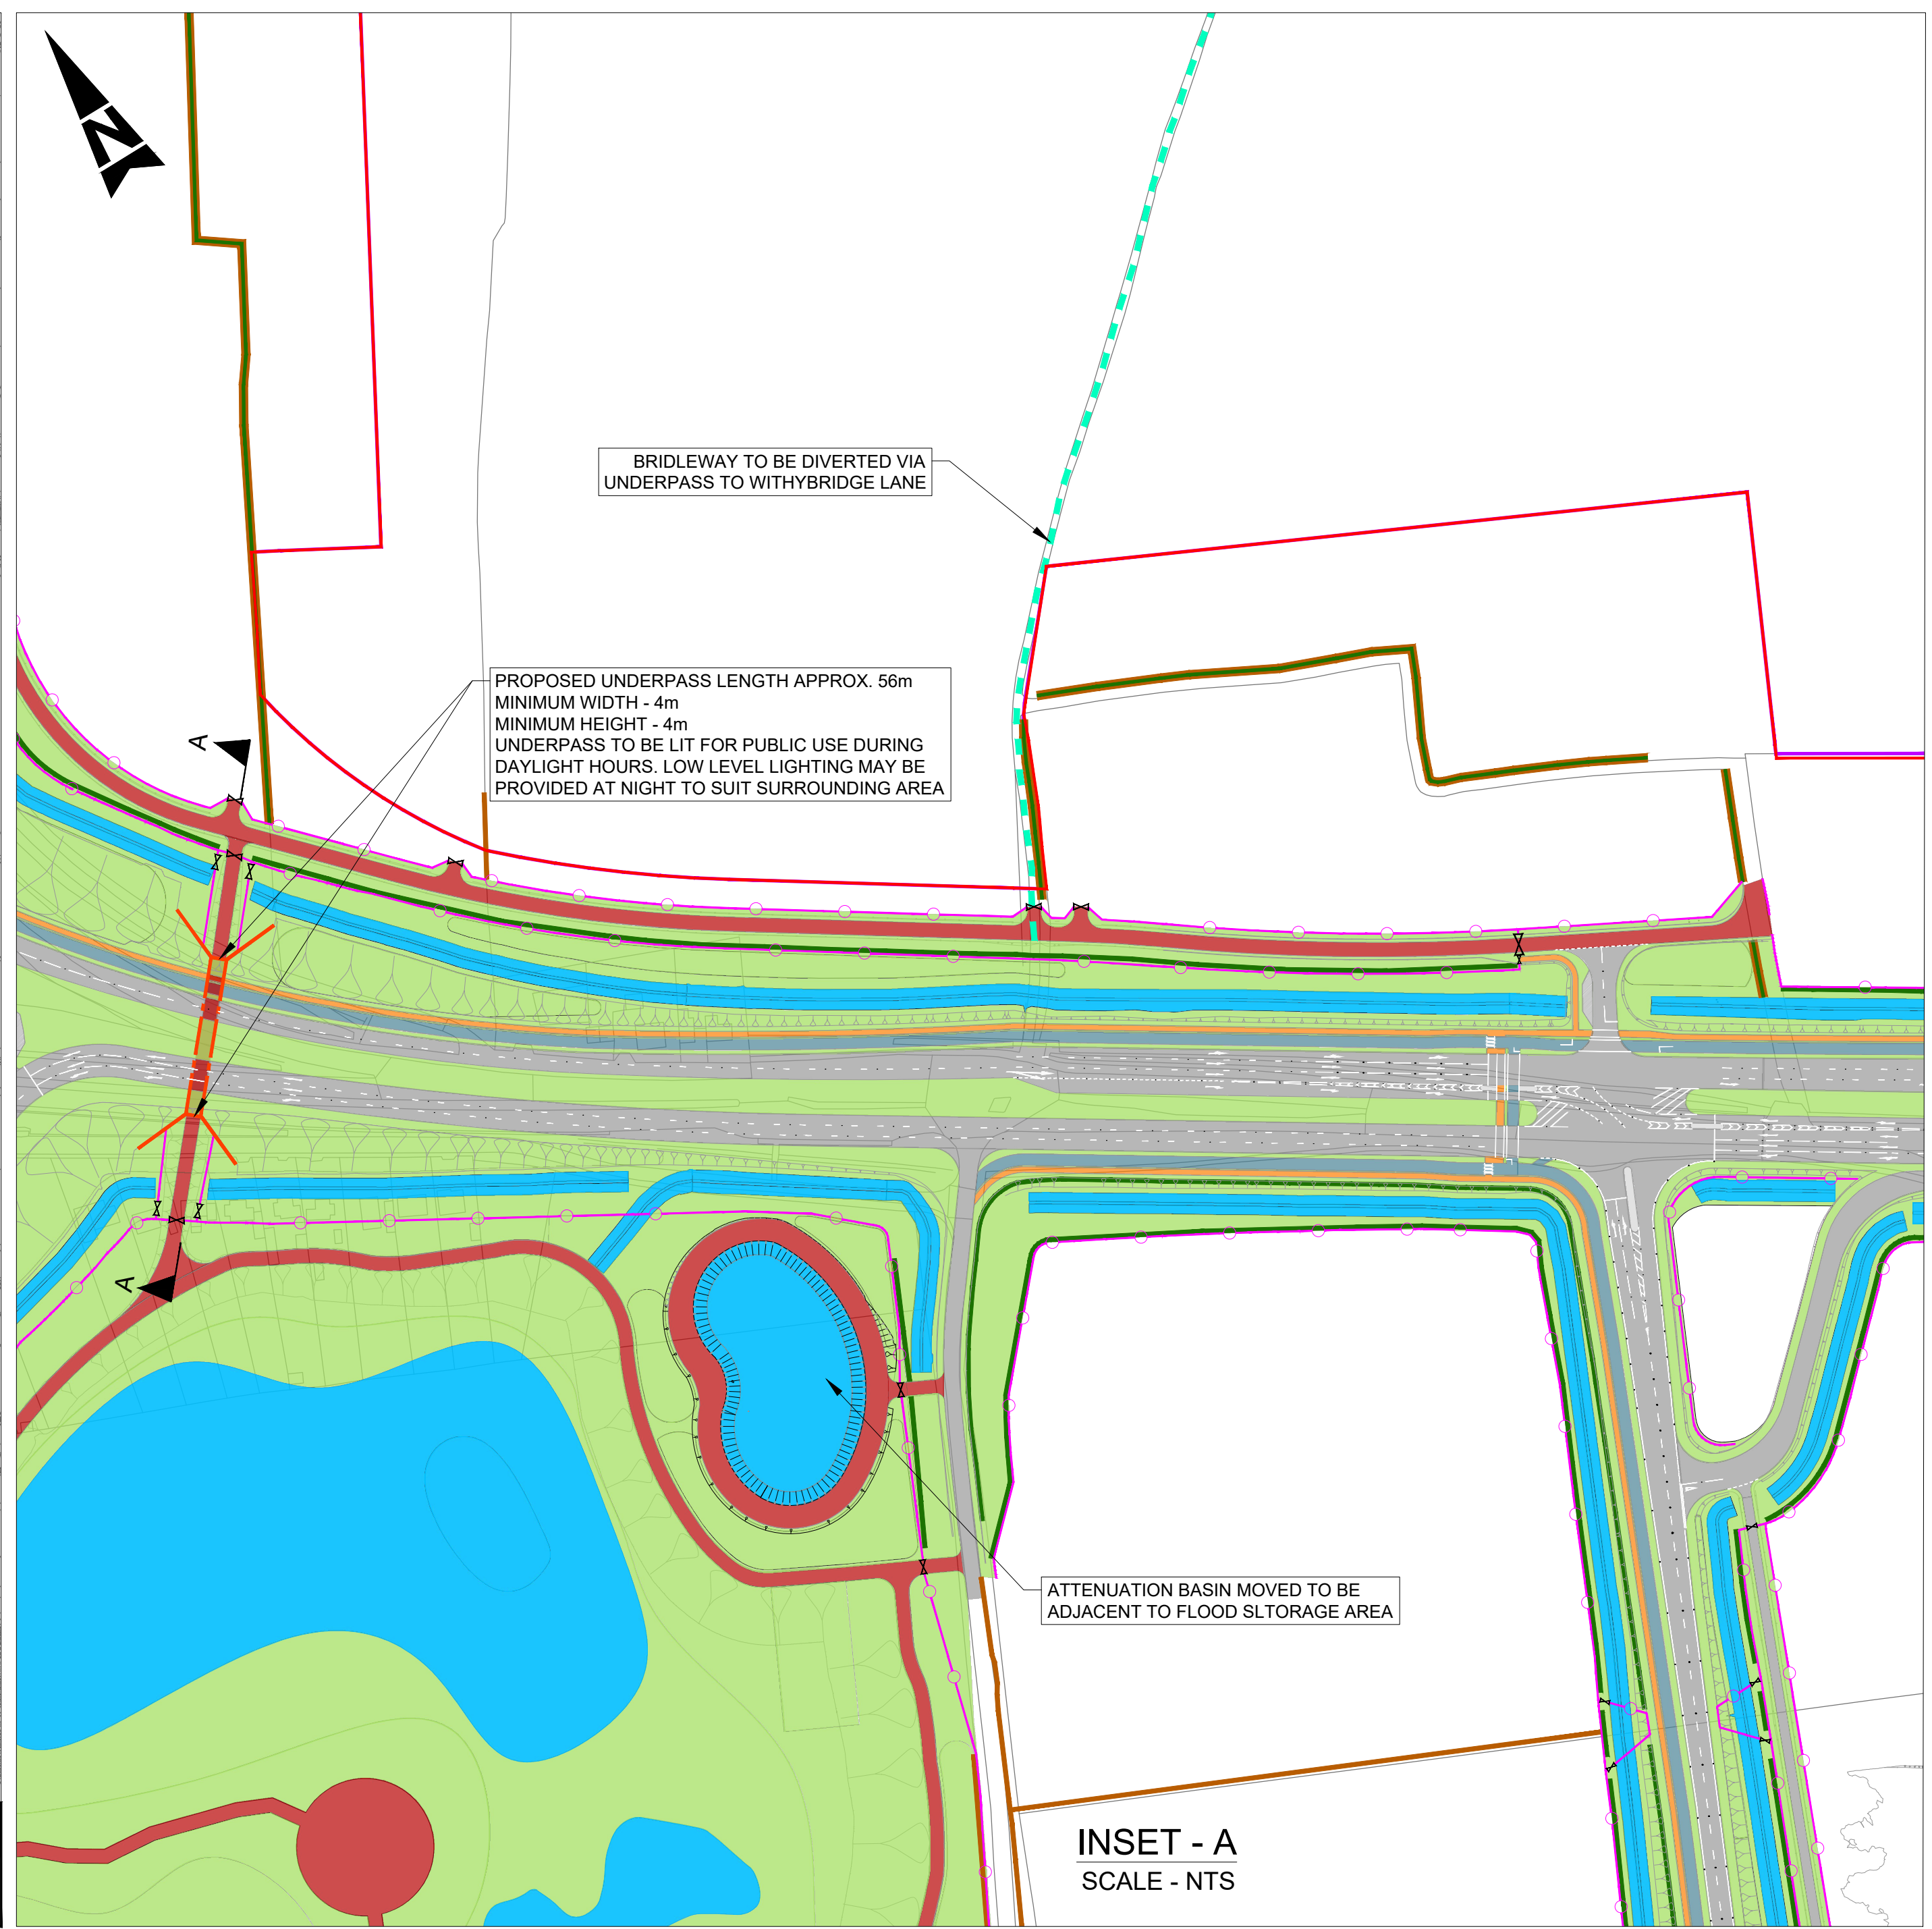


DO NOT SCALE

Millimetres

0 10 100

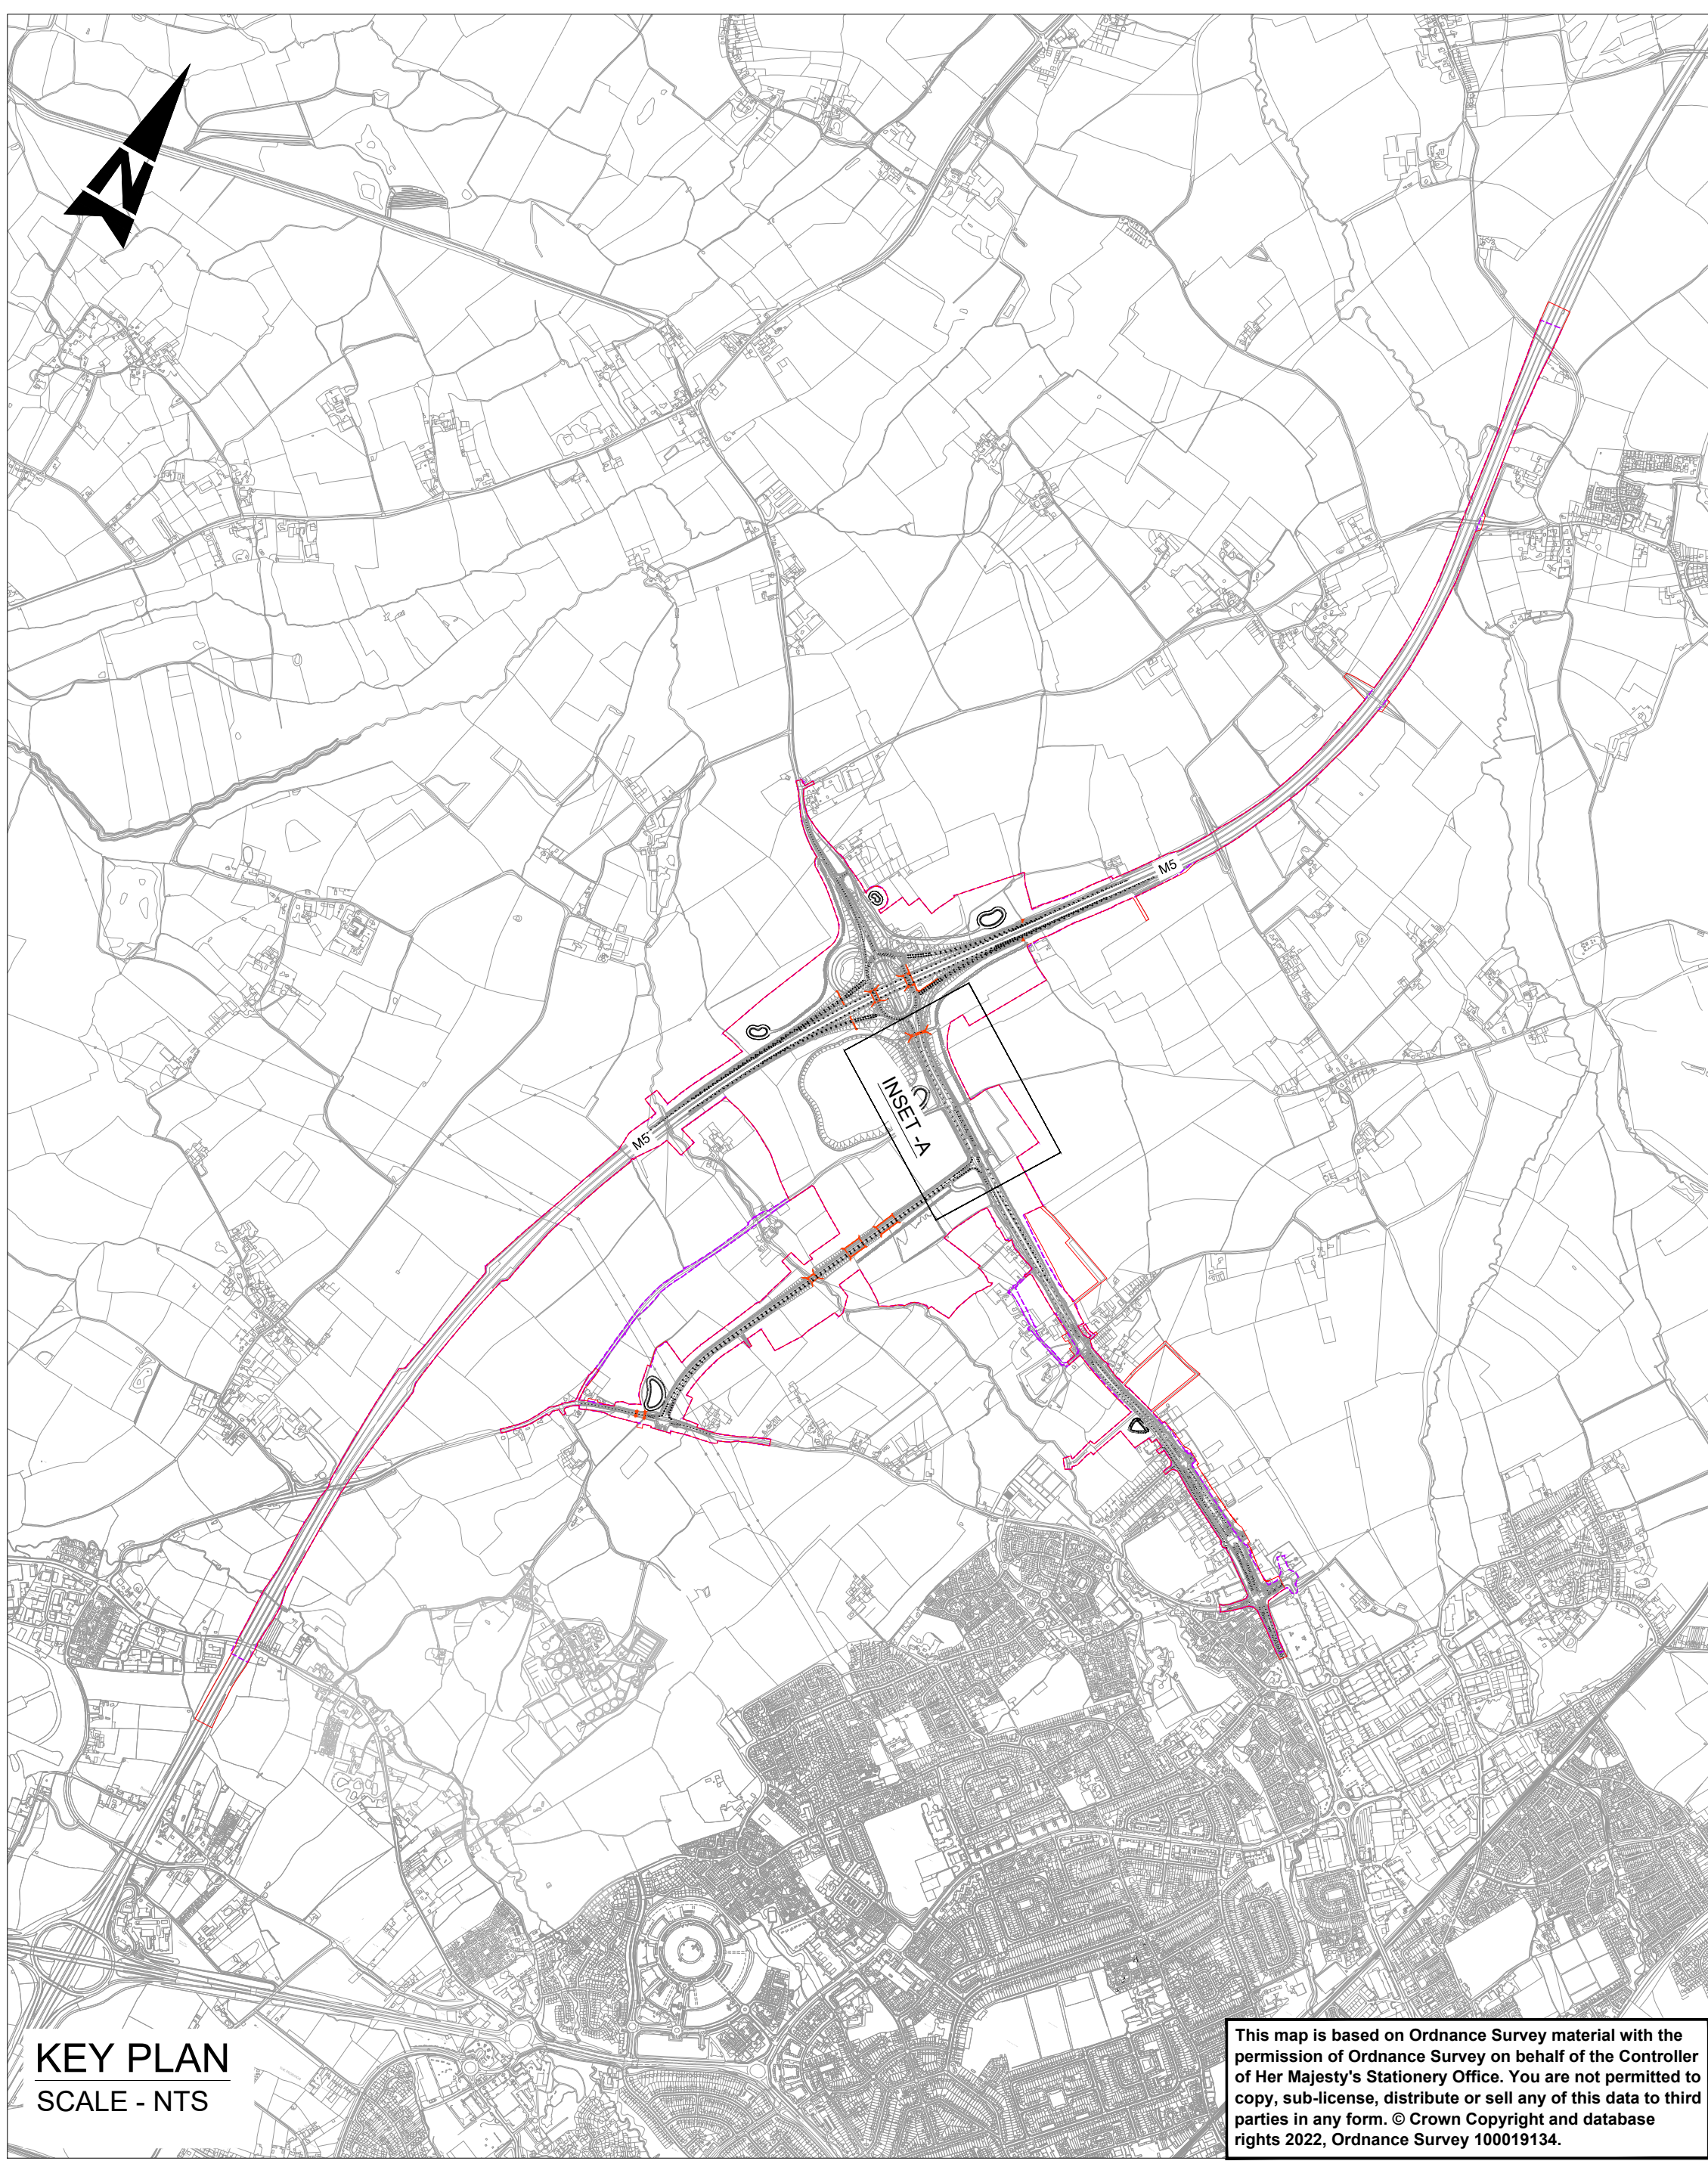

NOTES	
1. ALL DIMENSIONS ARE IN METRES UNLESS OTHERWISE STATED.	
KEY :	
	INDICATIVE APPLICATION RED LINE BOUNDARY (RLB) FOR TARGETED CONSULTATION
	INDICATIVE APPLICATION RED LINE BOUNDARY (RLB) FOR PUBLIC CONSULTATION
	PROPOSED HIGHWAY FENCING
	PROPOSED REFLECTIVE NOISE BARRIER 2m HIGH
	PROPOSED GATE
	PROPOSED OVERBRIDGE
	PROPOSED UNDERBRIDGE/CULVERT
	PROPOSED CARRIAGEWAY
	PROPOSED FOOTWAY
	PROPOSED CYCLE TRACK
	PROPOSED SHARED USE PATH
	PROPOSED ACCESS TRACK
	PROPOSED ISLAND
	EXISTING HEDGEROW - TO BE RETAINED
	EXISTING HEDGEROW - TO BE ENHANCED
	PROPOSED VEGETATION
	WATER BODIES/ DITCHES

#### SAFETY, HEALTH AND ENVIRONMENTAL INFORMATION

In addition to the hazards/risks normally associated with the types of work detailed on this drawing, note the following significant residual risks (Reference shall also be made to the design hazard log).

Construction  
Not identified at this stage

Maintenance / Cleaning  
Not identified at this stage

Use  
Not identified at this stage

Decommissioning / Demolition  
Not identified at this stage

Description

Status	Revision	Drawn	Checked	Reviewed	Authorised	Issue Date
--------	----------	-------	---------	----------	------------	------------














